

CENTRAL MAPPING AUTHORITY
Department of Lands

Trigonometrical Survey of N.S.W.

RECONNAISSANCE and MAINTENANCE REPORT

This Trig. Station has been:-

Note: Cross out word or words which do not apply

1. Completely cleared to permit 360° vision to surrounding Trigs.
2. Cleared by lanes bearing from Trig. Mast
3. Trig. Mast & Vanes have been painted white & black respectively.
4. The Trig. was unpiled/not unpiled, dimensions now being: Original Station Mark found not found

Description of mark... Plug in rock should be explicit, e.g. Steel plug, Brass plug, Bolt, G.I. Pipe

Height of mark..... m ^{above} _{below} rock/concrete m ^{above} _{below} G.L.
Diameter of Vanes (vertical)..... m.

Height of Cairn..... m. Diameter of Cairn..... m.

Length of Mast..... m. (approximate if not unpiled)

5. A..... set in conc/rock has been placed..... m. bearing.....°M from Trig. Mast
6. A..... set in conc/soil has been placed..... m. bearing.....°M from Trig. Mast
7. A..... set in conc/soil has been placed..... m. bearing.....°M from Trig. Mast
8. A..... set in conc/rock has been placed..... m. bearing.....°M from Trig. Mast

9. Connection..... to..... m. bearing.....°M

10. Connection..... to..... m. bearing.....°M

11. Connection..... to..... m. bearing.....°M

12. Connection..... to..... m. bearing.....°M

13. Diff. Ht. is..... m. ^{above} _{below}

14. Diff. Ht. is..... m. ^{above} _{below}

15. Diff. Ht. is..... m. ^{above} _{below}

16. Diff. Ht. is..... m. ^{above} _{below}

Prepared by:

Checked:

Noted on U.T.M. Card

STATION SARATOGA

TS 4027

Co. Ph:

Map Sheet: COSFORD

No: 9131

Inspected by:

Date:

Authority:

Field Book:

Beacon Diagram

Net to Scale

Date

(94)

Record of Station

Station Established


Checked

STATION 15 4027 SARATOGA (P.)

Owners Name.....
 Current Occupant.....
 Address.....
 Address.....

Access
 Kms
 0.0
 0.15
 0.25
 0.65
 1.0
 1.05

Feature
 Saratoga P.O. (Within Saratoga shopping complex) 1.05 km East
 Turn right from Stayne Road East.
 Turn left into Stayne road.
 Turn left into View Pde towards Lookout.
 Turn right into Lydred St.
 Leave vehicle at Mt. Pleasant Lookout sign
 Walk up rock steps to top of hill and Lookout
 10 min. walk to Trig from base of hill.

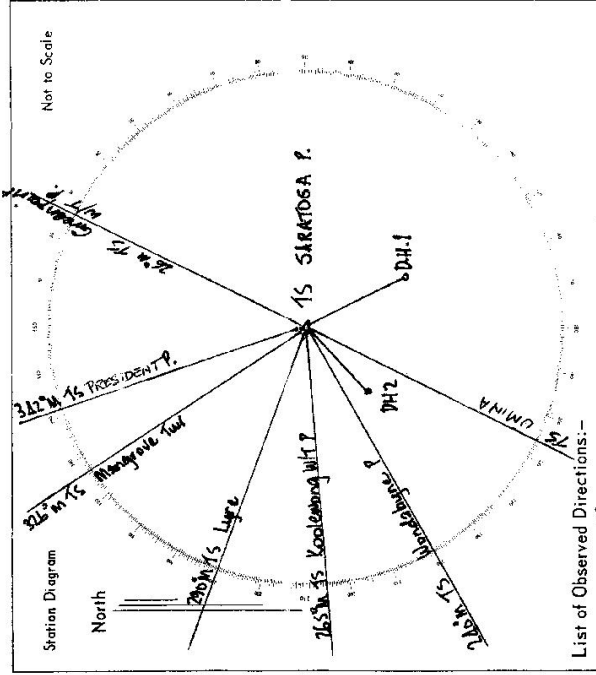

List of Observed Directions:-

Standpoint: Pillar

Station	Direction	Station	Direction
15 Wondabyne P	D. 00' 00"	15 Wondabyne P	0° 00' 00"
15 Koolamong Hill P	25° 18' 52.36"	15 Pillar plate	172° 41' 53.8"
15 Lyre	51° 54' 07.67"	15 D.H. 1	224° 39' 29"
15 Mangrove Tur	87° 11' 47.08"		
15 PRESIDENT P	102° 23' 08.58"		

Station	Direction	Station	Direction
15 Green Point Hill P	186° 47' 26.06"		
15 D.H. 1	272° 02' 52.5"		
15 UMINIA	327° 28' 05.5"		
15 D.H. 2	352° 48' 26.0"		