

CENTRAL MAPPING AUTHORITY

GEODETIC SURVEY OF N.S.W.

GEODETIC STATION RECONNAISSANCE and MAINTENANCE REPORT

STATION: **SASSAFRAS**

MAP SHEET  
SCALE 1:250 000

INSPECTED BY: **J. JUDGE / R. ELLIS**

DATE: **12 - 8 - 81**

FIELD BOOK: **L O 135**

Description: *Note: Cross out word or words which do not apply*

1. Cleared by lances bearing..... from Trig. Mast
2. Mast & Vanes have been painted white & black respectively.
3. The station/pillar was applied/not unpiled/constructed on..... 12.7..... 19.8 L., dimensions now being:  
Description of mark..... should be explicit, e.g., S/Steel Pillar Plate, Steel plug, Brass plug, Bolt, G.I. Pipe  
Height of mark..... m. <sup>above</sup> rock/concrete; Mark is..... m. <sup>above</sup> G.L.  
Height of Top Vanes to Top Mark/Pillar plate..... m. Diameter of Vanes (vertical)..... m.  
Height of Cairn..... m. Diameter of Cairn..... m. Name Plate found/not found/placed.  
Length of Mast..... m. (approximate if not unpiled)
4. A..... set in conc/rock has been placed/found, bearing..... °M from Mast/Plug/Pillar
5. A..... set in conc/rock has been placed/found, bearing..... °M from Mast/Plug/Pillar
6. A..... set in conc/rock has been placed/found, bearing..... °M from Mast/Plug/Pillar
7. A..... set in conc/rock has been placed/found, bearing..... °M from Mast/Plug/Pillar
8. Action required:..... - POSSIBLE MAPPING USE ONLY.....


STANDPOINT:

Mark	Direction	Horiz. Distance	Height Difference	Mark	Direction	Horiz. Distance	Height Difference
			above standpt.				above standpt.
			below standpt.				below standpt.
			above standpt.				above standpt.
			below standpt.				below standpt.
Prepared by: *MLL* 23/9/81

Checked: *MLL*

Noted on U.T.M. Card

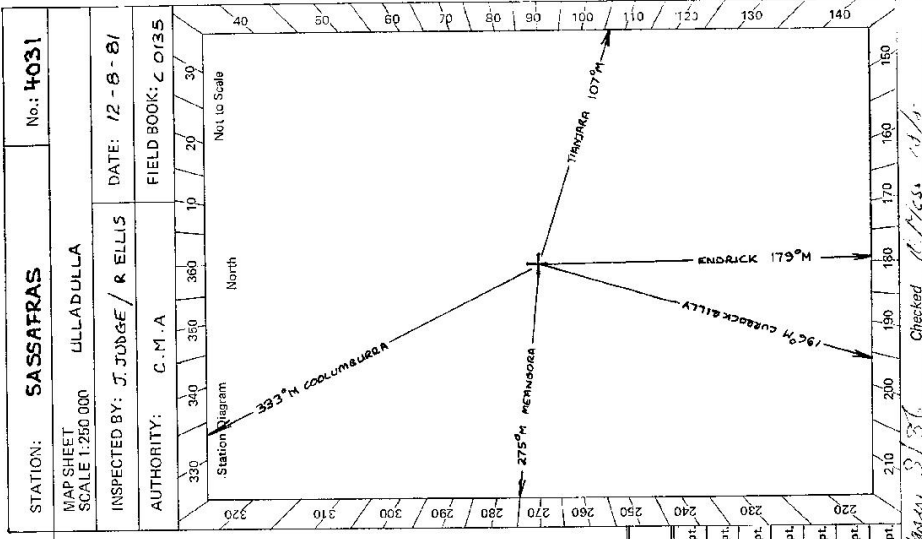

GS 24

STATION **SASSAFRAS** TS **4031**

Owner's Name: **MORTON NATIONAL PARK**  
 Address: .....  
 Phone: .....  
 Current Occupant: .....  
 Address: .....  
 Phone: .....

**ACCESS**

Access Report of **12/8/1981** was found suitable/unsuitable.  
 Feature  
 Km. ON PRINCES HWY STL OF MOURA; TURN RIGHT OPPOSITE "SEA VENOM" PLANE  
 TOWARDS HMAS ALBATROSS, BARRIKER, BRW DWOOD.  
 7-0 TURN RIGHT TOWARDS BRADWOOD.  
 23-7 TURN RIGHT TOWARDS BRADWOOD.  
 35-1 PASS "BOOLLITAH" TRIG ON LEFT.  
 47-80 TURN LEFT THROUGH IRON GATE AT TOP OF RISE. ~ LARGE EQUIPMENT SHED ON LEFT.  
 FOLLOW TRACK BETWEEN SHED AND OLD HUT ON RIGHT.  
 48-56 PASS TRACK THAT VEERS TO LEFT TO "329 - 327" TOWER NPS.  
 48-61 VEER RIGHT OFF MAIN TRACK AND FOLLOW FAINT TRACK.  
 49-05 PASS TO THE RIGHT OF TOWER N° 323  
 49-37 WIRE GATE ~ TURN RIGHT AFTER GATE  
 51-25 WIRE GATE IN 38.1P FENCE  
 54-3 OPENING IN OLD WIRE FENCE.  
 55-64 TRACK TURNS RIGHT UP SLOPE  
 55-79 "SASSAFRAS" TRIG ON LEFT.

Beacon Diagram	Not to Scale
<i>CHAIN POLE &amp; DISCS IN REASONABLE CONDITION</i>	
<i>- ALTHOUGH SPARSELY VEGETATED THE HILL IS VERY LOW AND FLAT AND WOULD REQUIRE LONG LINES (NATIONAL PARK AREA)</i>	

This section to be completed by officer constructing pillar.

Original station mark found/not found.

Description of mark: .....

Original beacon found/not found.

Description of beacon: .....

Height Top of Vanes to Top Mark: .....m.

Height of mark: .....m. above G.L.  
 below

Diameter of Vanes: .....m. Height of Cairn: .....m.

Original Beacon has/has not been destroyed by me.

Date	Record of Station