

STATION *SAVAGE TS 4032*


Owner's Name: *Ceoff. Russell*
 "Sindarue"
 Address: *11000 E. 1st Ave. S. Burwood*
 Phone:

Current Occupant: *OWNER*
 Address:

ACCESS

Access Report of *19/1981* was found suitable/unsuitable.

- 0.00 Broadwood PQ
- 0.44 Straight Ahead (Bateman Bay Rd on left)
- 0.66 Turn Right Follow MORUVA Rd
- 0.97 Turn Left Follow MORUVA Rd
- 2.63 Straight Ahead (Captains Flat Rd on right)
- 3.90 Turn Right - Sign "Majors Creek 13"
- 11.85 Bridge over "Majors Creek"
- 12.40 Turn left onto gravel road
- 14.85 Causeway
- 14.95 Turn right thru iron gate & head in direction 285° M towards top of hill following foot track
- 15.75 TRAIL

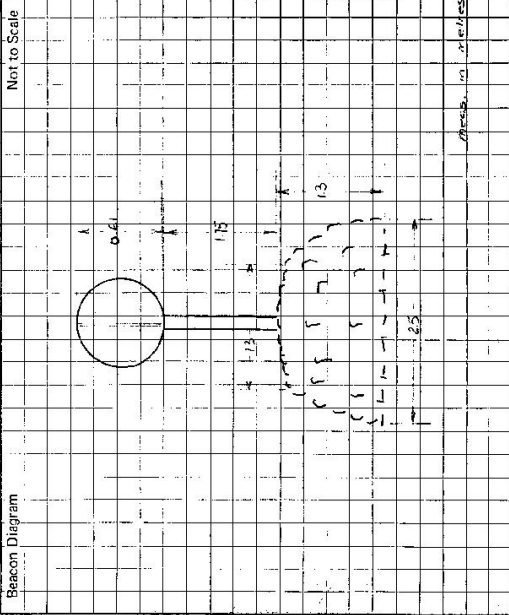

This section to be completed by officer constructing pillar.

Original station mark found/not found.

Description of mark:

Original beacon found/not found.

Description of beacon:

Height Top of Vanes to Top Mark.....m.

Height of mark.....m. above G.L.
 below

Diameter of Vanesm. Height of Cairnm.

Original Beacon has/has not been destroyed by me.

Date

Record of Station