

75193

Department of Lands Integrative Survey of N.S.W.  
**RECONNAISSANCE and MAINTENANCE REPORT**

STATION **T.S. 4044** **SCOPES**

Co: **TRANSORA** Ph: **-**  
 Map Sheet: **TOPOG 1:100000** No: **7334**  
 Inspected by: **C.W. STACEY** Date: **22-9-81**  
 Authority: **I.S.B.** Field Book: **TPP 1540**  
 Beacon Diagram Not to Scale

This Trig. Station has been: Note: Cross out word or words which do not apply

1. Completely cleared to permit 360° vision to surrounding Trigs.
2. ~~Cleared by James bearing~~ from Trig-Mast
3. ~~Trig-Mast & Vanes have been painted white & black respectively.~~


4. The Trig. was unpiled/not unpiled, dimensions now being:

Description of mark: **COPPER TUBE IN CONC.** should be explicit, e.g. Steel plug, Brass plug, Bolt, Concrete Pillar  
 Height of mark: above m below rock/concrete m G.L.  
 Height of Top Vanes to Top Mark/Top pillar plate: above m below Diameter of Vanes (vertical): above m  
 Height of Cairn: above m below Diameter of Cairn: above m  
 Length of Mast: above m. (approximate if not unpiled)

5. A. ~~CONCRETE 1~~ set in conc/soil has been placed/rd **6.798** m, bearing **303** °M from Trig. Mast/pillar
6. A. ~~CONCRETE 2~~ set in conc/soil has been placed/rd **4.512** m, bearing **24** °M from Trig. Mast/pillar
7. A. set in conc/soil has been placed/rd above m, bearing above °M from Trig. Mast/pillar
8. A. set in conc/rock has been placed/rd above m, bearing above °M from Trig. Mast/pillar

9. Connection ~~CONCRETE 1~~ to ~~CONCRETE 2~~ **TUBE** is **7.56** m, bearing **86** °M
10. Connection: above to above m, bearing above °M
11. Connection: above to above m, bearing above °M
12. Connection: above to above m, bearing above °M
13. Diff. Hr. ~~CONCRETE TUBE 1~~ is **0.11** m, above **TRIG. PILE**
14. Diff. Hr. ~~CONCRETE TUBE 2~~ is **0.23** m, above **TRIG. PILE**
15. Diff. Hr. above is above m, above
16. Diff. Hr. above is above m, above

Prepared by: **G. Ayle** Checked: **GP**

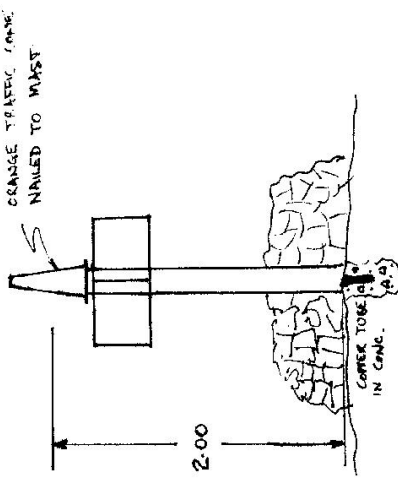

Date	Record of Station
22/9/81	SEARCHED OCCUPIED


STATION T.S. 4044 SCORES.

Owners Name..... Current Occupant.....


Address.....

Access 22-9-1981

0.0 LITTLE TOTAR HOTEL, TRANCEL EAST ALONG BARBER HWY  
 17.7 TOWN SIGN OFF HWY 20 M EAST OF CATTLE GRID NEX SCORES BOKE  
 18.8 GATE. TRACK CURVES RIGHT + FOLLOWS FCE SOUTH.  
 20.6 GATE. TRACK CURVES LEFT.

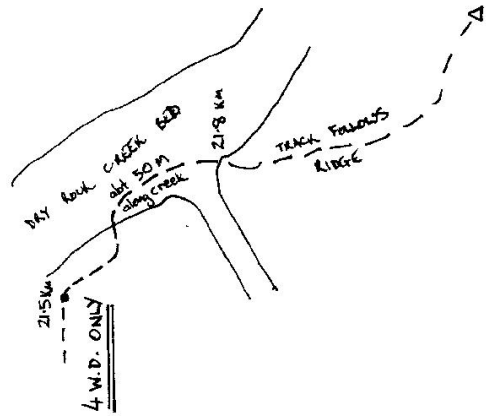

Station Diagram  
 Mag North

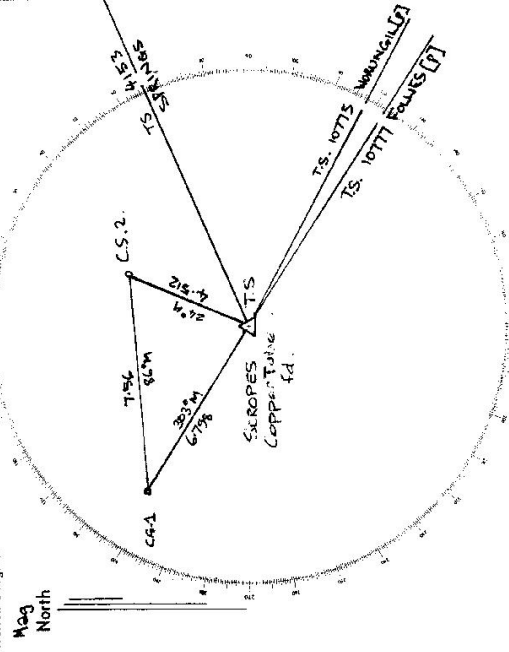

List of Observed Directions:-

Station	Direction	Station	Direction
TS-10775 WARRINGAIL [?]	120° 50' 00"	Station	Direction
TS 10777 FOLLIES [?]	120° 48' 01"		
TS 4053 SPRINGS	6° 04' 33"		
TS 4044 CS.1	302° 38' 36"		
TS 4044 CS.2	23° 49' 11"		
TAKEN FROM STATION SUMMARY 1940/1			