

CENTRAL MAPPING AUTHORITY

GEODETIC SURVEY OF N.S.W.

GEODETIC STATION RECONNAISSANCE and MAINTENANCE REPORT

STATION: SCOTT No.: 4046

MAP SHEET SCALE 1:250 000

CANBERRA

INSPECTED BY: G. C. HANNA DATE: 26/4/79

AUTHORITY: C.M.A. FIELD BOOK:

- Description:
- Note: Cross out word or words which do not apply*
- Cleared by lanes bearing..... from Trig. Mast
 - Mast & Vanes have been painted white & black respectively.
 - The station/pillar was unpiled/not unpiled/constructed on..... 19..... dimensions now being:
 - Description of mark..... should be explicit, e.g. S/Steel Pillar Plate, Steel plug, Brass plug, Bolt, G.I. Pipe
 - Height of mark..... m. ^{above} rock/concrete; Mark is..... m. ^{above} G.L.
 - Height of Top Vanes to Top Mark/Pillar plate..... m. Diameter of Vanes (vertical)..... m.
 - Height of Cairn..... m. Diameter of Cairn..... m. Name Plate found/not found/placed.
 - Length of Mast..... m. (approximate if not unpiled)
 - A..... set in conc./rock has been placed/found, bearing..... °M from Mast/Plug/Pillar
 - A..... set in conc./rock has been placed/found, bearing..... °M from Mast/Plug/Pillar
 - A..... set in conc./rock has been placed/found, bearing..... °M from Mast/Plug/Pillar
 - A..... set in conc./rock has been placed/found, bearing..... °M from Mast/Plug/Pillar
 - Action required:.....


STANDPOINT:

Mark	Direction	Horiz. Distance	Height Difference	Mark	Direction	Horiz. Distance	Height Difference
			above standpt.				above standpt.
			below				below
			above standpt.				above standpt.
			below				below
Prepared by: G. Hanna 8/5/79 Checked:

Noted on U.T.M. Card


SI 2733-1

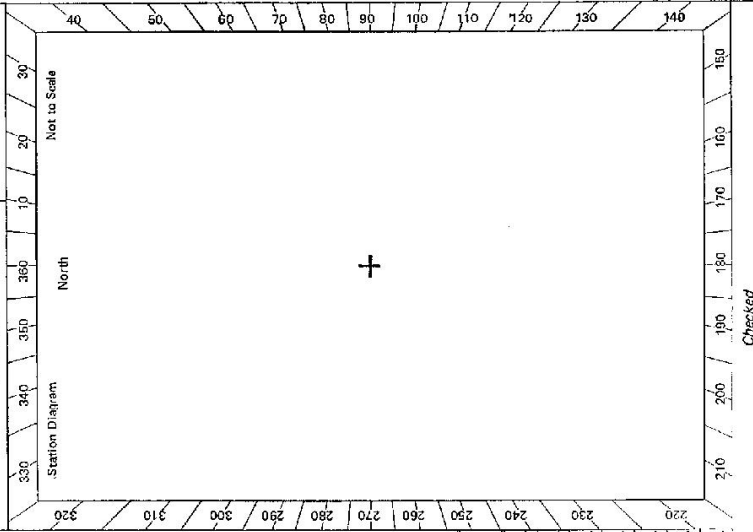

Er-2723-2 D. West, Government Printer

Beacon Diagram

Not to Scale

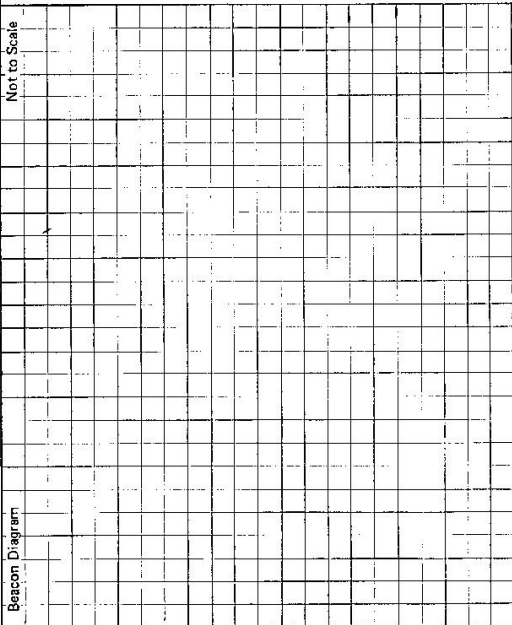


Owner's Name:
 Address:
 Phone:

Current Occupant:
 Address:
 Phone:

ACCESS

Access Report of 26.4.1979 was found suitable/unsuitable.

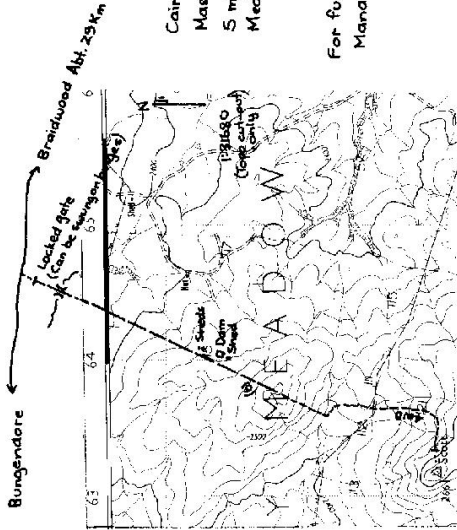

Cairn found.
 Mast & vanes found destroyed
 5 minute walk
 Medium clearing required

For further information see:
 Manar 8827- III - N

Date

Record of Station

This section to be completed by officer constructing pillar.

Original station mark found/not found.

Description of mark:

Original beacon found/not found.

Description of beacon:

Height Top of Vanes to Top Markm.

Height of markm. above rock/conc. below G.L.

Diameter of Vanesm. Height of Cairnm.

Original Beacon has/has not been destroyed by me.

STATION SCOTT

TS 4046

G