

GEODETTIC SURVEY OF NS.IK

CENTRAL MAPPING AUTHORITY


GEODETTIC STATION RECONNAISSANCE and MAINTENANCE REPORT

STATION: **SEBASTAPOL T.S.** No.: **4055**

MAP SHEET SCALE 1:250 000 **HOLLONGONG**

INSPECTED BY: **M.L. Morrison** DATE: **6-2-81**

AUTHORITY: **C.M.A.** FIELD BOOK: **—**

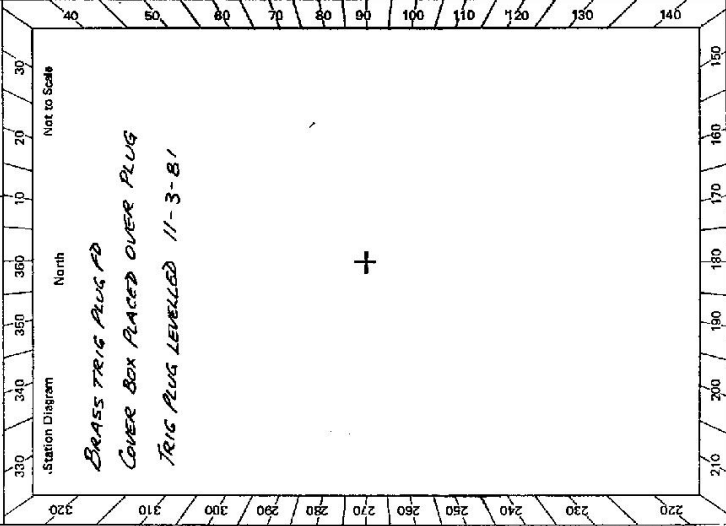

- Description:
- Note: Cross out word or words which do not apply
1. Cleared by lanes bearing..... from Trig. Mast
 2. Mast & Vanes have been painted white & black respectively.
 3. The station/pillar was unpiled/not unpiled/constructed on..... 19....., dimensions now being: Description of mark..... should be explicit, e.g., S/Steel Pillar Plate, Steel plug, Brass plug, Bolt, G.I. Pipe
Height of mark..... m. ^{above} _{below} rock/concrete; Mark is..... m. ^{above} _{below} G.I.
Height of Top Vanes to Top Mark/Pillar plate m. Diameter of Vanes (vertical)..... m.
Height of Cairn..... m. Diameter of Cairn..... m. Name Plate found/not found/placed.
Length of Mast m. (approximate if not unpiled)
 4. A..... set in conc/rock has been placed/found, bearing..... °M from Mast/Plug/Pillar
 5. A..... set in conc/rock has been placed/found, bearing..... °M from Mast/Plug/Pillar
 6. A..... set in conc/rock has been placed/found, bearing..... °M from Mast/Plug/Pillar
 7. A..... set in conc/rock has been placed/found, bearing..... °M from Mast/Plug/Pillar
 8. Action required.....

STANDPOINT:							
Mark	Direction	Horiz. Distance	Height Difference	Mark	Direction	Horiz. Distance	Height Difference
			above standpt.				above standpt.
			below standpt.				below standpt.
			above standpt.				above standpt.
			below standpt.				below standpt.
Prepared by: **18/3/81** Checked: **18/3/81** Noted on U.T.M. Card

STATION SEBAS POL.

Owners Name..... Current Occupant.....

Address..... Address.....


Access

TAKE PRINCES HIGHWAY SOUTH TO INTERSECTION WITH HEATHCOTE RD
 00 KM AT HEATHCOTE.

1.6 KM. ON RIGHT IS SEBASTOPOL TS (NOT VISIBLE FROM ROAD)
 "TANROD DOG KENNELS" IS ON LEFT.

TO DRIVE TO SEBASTOPOL DO A U TURN AT NEXT
 BREAK IN TRAFFIC ISLAND THEN TAKE FIRST
 TRACK ON LEFT THIS WILL BRING YOU DIRECTLY TO
 TS IN OLD GRAVEL PIT.

Station Diagram

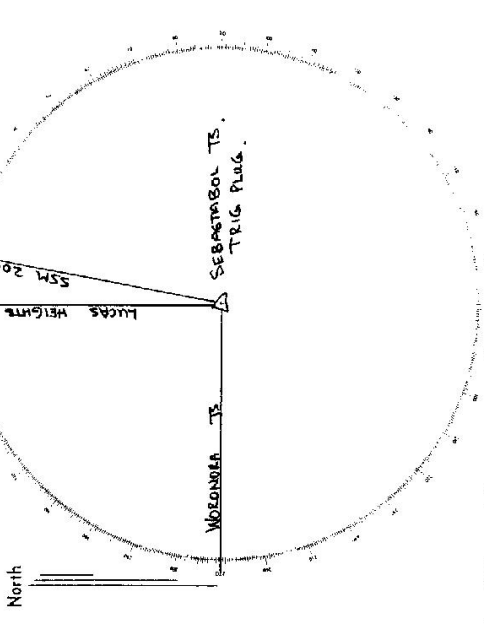

List of Observed Directions:-

Standpoint: TRIG PLUG		Standpoint:	
Station	Direction	Station	Direction
WOLONGARA	0° 00' 00"		
LUCAS HEIGHTS TS	88° 45' 06"		
SSM 20410	101° 09' 14"		
Station	Direction	Station	Direction