

CENTRAL MAPPING AUTHORITY

GEODETIC SURVEY OF N.S.W.

GEODETIC STATION RECONNAISSANCE and MAINTENANCE REPORT

- Description: *Note: Cross out word or words which do not apply*
1. Cleared by lanes bearing..... from Fig. Mast
 2. Mast & Vanes have been painted white & black respectively.
 3. The station/pillar was unpiled/hot unpiled/constructed on..... 19....., dimensions now being:
Description of mark..... should be explicit, e.g., S/Steel Pillar Plate, Steel plug, Brass plug, Bolt, G.I. Pipe
Height of mark.....m. ^{above} rock/concrete; Mark is.....m. ^{above} G.L.
Height of Top Vanes to Top Mark/Pillar plate.....m. Diameter of Vanes (vertical).....m.
Height of Cairn.....m. Diameter of Cairn.....m. Name Plate found/not found/placed.
Length of Mast.....m. (approximate if not unpiled)
 4. A..... set in conc/rock has been placed/found, bearing.....°M from Mast/Plug/Pillar
 5. A..... set in conc/rock has been placed/found, bearing.....°M from Mast/Plug/Pillar
 6. A..... set in conc/rock has been placed/found, bearing.....°M from Mast/Plug/Pillar
 7. A..... set in conc/rock has been placed/found, bearing.....°M from Mast/Plug/Pillar
 8. Action required.....

STANDPOINT:

Mark	Direction	Horiz. Distance	Height Difference	Mark	Direction	Horiz. Distance	Height Difference
			above standpt.				above standpt.
			below standpt.				below standpt.
			above standpt.				above standpt.
			below standpt.				below standpt.
Prepared by: *Goffman* 8-5-80 Checked: *Stable* 3/10/80

Noted on U.T.M. Card

Sr 2733-1

STATION: SHAW No.: 4072
 MAP SHEET SCALE 1:250,000 BEGR
 INSPECTED BY: G.C.HRNNA DATE: 5-5-80
 AUTHORITY: C.M.A. FIELD BOOK:

C

2733-2 D. West, Government Printer

<p>Beacon Diagram</p> <div style="border: 1px solid black; width: 100%; height: 150px; margin-bottom: 5px;"></div> <p style="text-align: right; font-size: small;">Not To Scale</p>	<table style="width: 100%; border-collapse: collapse;"> <tr> <td style="width: 50%; border-right: 1px solid black;"> <p style="text-align: center;">STATION SHAW TS 4072</p> <p>Owner's Name:</p> <p>Address:</p> <p>Phone:</p> <p style="text-align: center;"><u>ACCESS</u></p> <p>Access Report of 5/5/1980 was found suitable/unavailable.</p> <p><u>ACCESS</u> See also Numbla Vale 8624 - N</p> <p style="text-align: center;">Km</p> <p>0-0 Dalgety P.O. towards Snowy River.</p> <p>0-5 L.H. turn towards Jimenbuen. Follow sealed road.</p> <p>8-4 L.H. turn towards "Ironmongie".</p> <p>13-1 Boundary gate "Ironmongie".</p> <p>15-65 R.H. turn at track.</p> <p>16-3 Turn right off track & follow ridge up hill.</p> <p>16-8 Stop at fence-line.</p> </td> <td style="width: 50%;"> <p>Current Occupant:</p> <p>Address:</p> <p>Phone:</p> <p>5 minute walk to trig.</p> <p>C, M & V found. M&V in need of paint.</p> <p>Light to medium cleaning required.</p> </td> </tr> </table>	<p style="text-align: center;">STATION SHAW TS 4072</p> <p>Owner's Name:</p> <p>Address:</p> <p>Phone:</p> <p style="text-align: center;"><u>ACCESS</u></p> <p>Access Report of 5/5/1980 was found suitable/unavailable.</p> <p><u>ACCESS</u> See also Numbla Vale 8624 - N</p> <p style="text-align: center;">Km</p> <p>0-0 Dalgety P.O. towards Snowy River.</p> <p>0-5 L.H. turn towards Jimenbuen. Follow sealed road.</p> <p>8-4 L.H. turn towards "Ironmongie".</p> <p>13-1 Boundary gate "Ironmongie".</p> <p>15-65 R.H. turn at track.</p> <p>16-3 Turn right off track & follow ridge up hill.</p> <p>16-8 Stop at fence-line.</p>	<p>Current Occupant:</p> <p>Address:</p> <p>Phone:</p> <p>5 minute walk to trig.</p> <p>C, M & V found. M&V in need of paint.</p> <p>Light to medium cleaning required.</p>
<p style="text-align: center;">STATION SHAW TS 4072</p> <p>Owner's Name:</p> <p>Address:</p> <p>Phone:</p> <p style="text-align: center;"><u>ACCESS</u></p> <p>Access Report of 5/5/1980 was found suitable/unavailable.</p> <p><u>ACCESS</u> See also Numbla Vale 8624 - N</p> <p style="text-align: center;">Km</p> <p>0-0 Dalgety P.O. towards Snowy River.</p> <p>0-5 L.H. turn towards Jimenbuen. Follow sealed road.</p> <p>8-4 L.H. turn towards "Ironmongie".</p> <p>13-1 Boundary gate "Ironmongie".</p> <p>15-65 R.H. turn at track.</p> <p>16-3 Turn right off track & follow ridge up hill.</p> <p>16-8 Stop at fence-line.</p>	<p>Current Occupant:</p> <p>Address:</p> <p>Phone:</p> <p>5 minute walk to trig.</p> <p>C, M & V found. M&V in need of paint.</p> <p>Light to medium cleaning required.</p>		
<p>Record of Station</p>			
<p>Date</p>			

This section to be completed by officer constructing pillar.

Original station mark found/not found.

Description of mark:

Original beacon found/not found.

Description of beacon:

Height Top of Vanes to Top Markm.

Height of markm. above below G.L.

Diameter of Vanesm. Height of Cairnm.

Original Beacon has/has not been destroyed by me.

LAND INFORMATION CENTRE

GEODETTIC SURVEY OF N.S.W.

GEODETTIC STATION RECONNAISSANCE and MAINTENANCE REPORT

Description:

- Cleared by lances bearing to 15° elev for C.P's *Note: Cross out word or words which do not apply*
- ~~Mast & Vanes~~ have been painted ~~white & black~~ respectively.
- The station/~~pillar~~ was unpilled/~~not unpilled/reconstructed~~ on 28 8 90, dimensions now being: 19.20
- Description of mark Steel Plug should be explicit, e.g., S/Steel Pillar Plate, Steel plug, Brass plug, Bolt, G.I. Pipe
Height of mark 0.047 m. ^{above} rock/~~concrete~~; Mark is above G.T. ON LARGE ROCK
- Height of Top Vanes to Top Mark/Pillar platem. Diameter of Vanes (vertical).....m.
- Height of Cairn.....m. Diameter of Cairn.....m. Name Plate found/not found/placed.
- Length of Mastm. (approximate if not unpilled)
- A.....set in conc/rock has been placed/found, bearing.....° M. from Mast/Plug/Pillar
- A.....set in conc/rock has been placed/found, bearing.....° M. from Mast/Plug/Pillar
- A.....set in conc/rock has been placed/found, bearing.....° M. from Mast/Plug/Pillar
- A.....set in conc/rock has been placed/found, bearing.....° M. from Mast/Plug/Pillar
- Action required: Re-pile Cairn as Re-top Pillar

STANDPOINT:

Mark	Direction	Horiz. Distance	Height Difference	Mark	Direction	Horiz. Distance	Height Difference
			above standpt.				above standpt.
			below				below
			above standpt.				above standpt.
			below				below
Prepared by: L.C. [Signature]

Checked: [Signature]

Noted on: U.T.M. Card

Checked: [Signature]

STATION: SHAW No.: 4072

MAP SHEET SCALE 1:250 000 BECA

INSPECTED BY: L. HITCHINS DATE: 28 8 90

AUTHORITY: LIC FIELD BOOK: -

Station Diagram

Not to Scale

STATION **SHAW TS 4072**


Owner's Name: **B.J + EG SEARS**
 Address: **"Ironmongie"**
via Bungarby (via Cooma)
 Phone: **064 536260**

Current Occupant: **OWNERS**
 Address:
 Phone:

ACCESS

Access Report of **28.8.1990** was found suitable/unsuitable.

- 0.0 DALCETY PO. CROSS BRIDGE OVER SNOWY RIVER
 - 0.5 L.H. TURN TOWARDS JIMENBVEN. FOLLOW SEALED ROAD
 - 8.4 L.H. TURN TOWARDS "IRONMONGIE"
 - 13.1 BOUNDARY GATE "IRONMONGIE"
 - 15.65 TURN RIGHT THROUGH GATE. CMA LOCK. FOLLOW TRACK.
 - 16.3 (CONTINUE ALONG MAIN TRACK TO OWNERS HOUSE)
 - 16.8 TURN RIGHT OFF TRACK + FOLLOW RIDGE UP HILL
- STOP AT FENCE LINE
 10 MIN WALK TO TRAIL
 CAIRN IS UNPAID. MEDIUM CLEARING REQUIRED

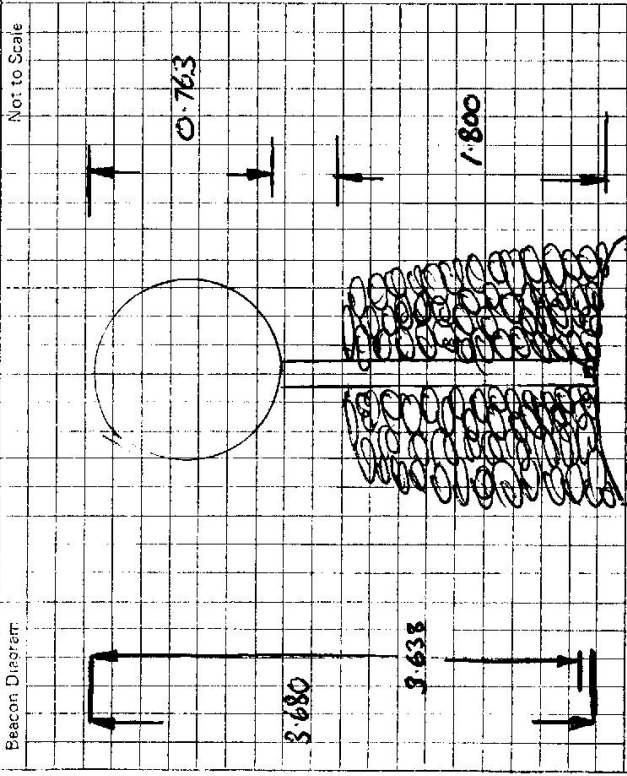

This section to be completed by officer constructing pillar.

Original station mark found: ~~none~~

Description of mark: **BRASS PILE IN ROCK**

Original beacon found: ~~none~~

Description of beacon: **CAIRN PILE + DECS**

Height: Top of Vanes to Top Mark **3.638** m.

Height of mark: **0.042** m. above rock **ON LARGE ROCK** below **1.800** m.

Diameter of Vanes **0.763** m. Height of Cairn **1.800** m.

Original Beacon has ~~been~~ been observed by me. **UNPAID**

Date	Record of Station