

GEODETIC SURVEY OF N.S.I.K.

CENTRAL MAPPING AUTHORITY

GEODETIC STATION RECONNAISSANCE and MAINTENANCE REPORT

Description:

1. Cleared by lanes bearing..... *Note: Cross out word or words which do not apply*
2. Mast & Vanes have been painted white & black respectively. *Mark below (As box) (Signified) from Trig. Mast*
3. The station/pillar was unpiled/not unpiled/constructed on..... 19....., dimensions now being:
Description of mark..... should be explicit, e.g., S/Steel Pillar Plate, Steel plug, Brass plug, Bolt, G.I. Pipe
Height of mark.....m. ^{above} rock/concrete; Mark is.....m. ^{above} G.L. ✓
Height of Top Vanes to Top Mark/Pillar plate.....m. Diameter of Vanes (vertical) ϕm.
Height of Cairn.....m. Diameter of Cairn.....m. Name Plate ~~found~~/not found/~~placed~~.
Length of Mast.....m. (approximate if not unpiled)

4. A..... *G.I. P. Plate* set in conc/~~rock~~ has been ~~placed~~/found, bearing..... 191° M from Mast/~~Plug/Pillar~~
5. A..... set in conc/rock has been placed/round, bearing..... M from Mast/Plug/Pillar
6. A..... set in conc/rock has been placed/round, bearing..... M from Mast/Plug/Pillar
7. A..... set in conc/rock has been placed/round, bearing..... M from Mast/Plug/Pillar

8. Action required: *Mast (S. Vanes) Marked. Replaced (Mast) set bearing for total clearing of hill, and the 3 piles with steel light to medium trees. Value is stopped for this but by higher interest hill, bearing So - West STANDPOINT.*

Mark	Direction	Horiz. Distance	Height Difference	Mark	Direction	Horiz. Distance	Height Difference
			above standpt.				above standpt.
			below standpt.				below standpt.
			above standpt.				above standpt.
			below standpt.				below standpt.
			above standpt.				above standpt.
			below standpt.				below standpt.
			above standpt.				above standpt.
			below standpt.				below standpt.

Prepared by: *D. S. S. S.* Checked: *H. S. S. S.* Noted on U.T.M. Card

81239-1

STATION: *Sheeba* No.: *TS 4076*
 MAP SHEET SCALE 1:250 000
 INSPECTED BY: *J. I. Kound* DATE: *24 October 1978*
 AUTHORITY: *C.M.A.* FIELD BOOK: *DLK 1*

Station Diagram

Not to Scale

Sheeba G.S. Trig. Mark only

G.I. P. in Cairn (Plate)

Checked

08

STATION Sheeba, G.S. TS 4076

Owner's Name:
 Address:
 Phone:


Current Occupant:
 Address:
 Phone:

ACCESS
 Access Report of: 4/12/1978 was found suitable/unsuitable.

Access to Sheeba G.S.

At Post Office Mound at 0.0 Kilometres, TAKE NORTHEAST ROAD
 AT SIGNPOST, TA NORTHEAST, 32 BARRY ✓
 KILOMETRES
 0 20 TAKE NORTHEAST, BARRY ROAD ON YOUR LEFT. ✓
 7 20 TAKE LEANED ROAD TO YOUR RIGHT AT SIGNPOST, BARRY, HANGING ROCK. ✓
 8 75 PASS DISUSED HANGING ROCK SCHOOL ON YOUR LEFT. ✓
 10 95 TURN ONTO TRACK ON YOUR RIGHT, THROUGH IRON GATE AND INTO PROPERTY, HANGING ROCK.
 (THIS IRON GATE IS OPPOSITE SHEEBA DAMS RESERVE.)
 11 25 THROUGH OLD WOOD GATE.
 11 40 PASS ABANDONED WOOD HOUSE AND THROUGH WIRE GATE.
 11 50 SLIP RAILS AND LARGE FALLEN TREE ACCESS TRACK VEHICLE WAS LEFT HERE
 ACCESS IS GAINED BY FOLLOWING MAIN TRACK NORTHEAST ONTO TIMBERED RIDGE
 THEN TO TRAIL ON WESTERN END OF ROCKY KNOLL. ABOUT ONE HALF MILE TO
 WITH CHAIN SAW TO CLEAR UP TRACK FOR A VERY EASY FIVE MINUTE WALK TO
 MILE. IMPORTANT NOTE: GATE TO PROPERTY INTERIOR COULD NOT BE LOCATED. PROPERTY
 HAS JUST BEEN SOLID POSSIBLY TO A SYDNEY GARDEN.

Date: Record of Station:

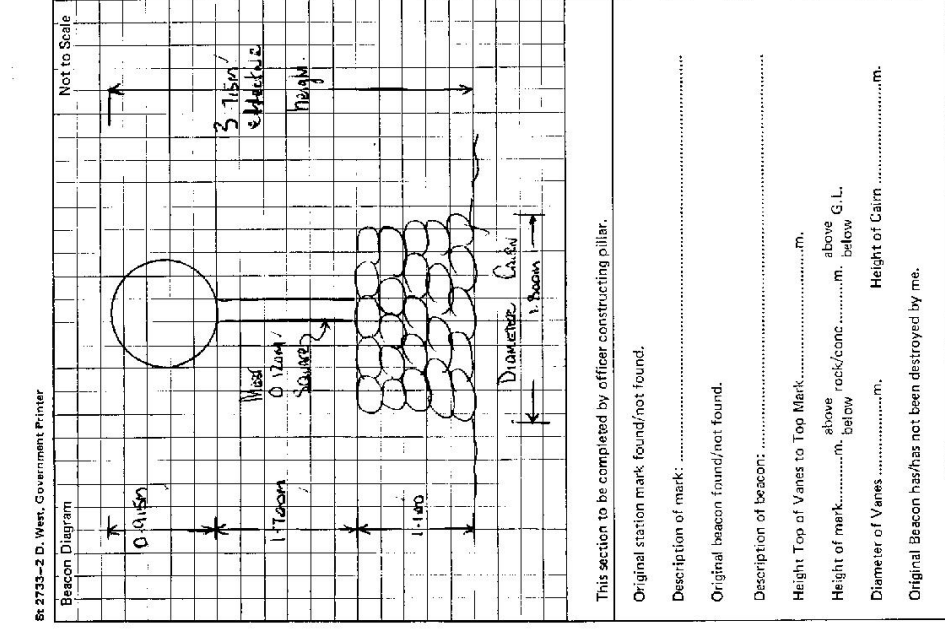

GEODETTIC SURVEY OF N.S.W.

CENTRAL MAPPING AUTHORITY

GEODETTIC STATION RECONNAISSANCE and MAINTENANCE REPORT

STATION: **SHIEBA** No.: **4076**

MAP SHEET SCALE 1:250 000

INSPECTED BY: **W.M. GILBERT** DATE: **5-3-79**

AUTHORITY: **CMA** FIELD BOOK: **1657**

Description: **360°** Note: Cross out word or words which do not apply

1. Cleared by lanes bearing..... from Trig, Mast

2. Mast & Vanes have been painted white & black respectively.

3. The station/pillar was unpiled/not unpiled/constructed on..... **5.197.9**, dimensions now being: **MAST SQUARE CORNERS**

Description of mark..... should be explicit, e.g., S/Steel Pillar Plate, Steel plug, Brass plug, Bolt, G.I. Pipe

Height of mark..... m. above/below rock/concrete; Mark is..... m. above/below G.L.

Height of Top Vanes to Top Mark/Pillar-plate **2.970** m. Diameter of Vanes (vertical) **1.010** m.

Height of Cairn..... m. Diameter of Cairn..... m. Name Plate found/not found/placed.

Length of Mast **2.770** m. (approximate if not unpiled)

4. A. **CONCRETE MARK** set in conc/rock has been placed/removed, bearing **310°** from Mast/Plug/Pillar

5. A. **G.I. PIPE** set in conc/rock has been placed/removed, bearing **197°** from Mast/Plug/Pillar

6. A. set in conc/rock has been placed/removed, bearing.....° from Mast/Plug/Pillar

7. A. set in conc/rock has been placed/removed, bearing.....° from Mast/Plug/Pillar

8. Action required:.....

Mark	Direction	Horiz. Distance	Height Difference	Mark	Direction	Horiz. Distance	Height Difference
YELLOW PIN PILLAR	359 57 60		above standpt.	YELLOW PIN PILLAR	359 59 60		above standpt.
G.I. PIPE	103 53 50	2.740	above standpt.	A.S.C. PLATE	104 22 50	3.015	0.075 below standpt.
NAIL	249 27 55		above standpt.	G.I. PIPE	132 35 20	4.999	0.169 below standpt.
CONCRETE MARK	284 26 40	3.015	above standpt.	NAIL	169 25 50		above standpt.
			below				below
			below				below
			below				below
			below				below

STANDPOINT: **CONCRETE MARK** Noted on U.T.M. Card

Prepared by: **W.M. GILBERT** 26.6.79

Checked: **W.M. GILBERT** 21.8.79

Station Diagram




Not to Scale

Checked: **W.M. GILBERT** 21.8.79

G:

STATION SHEEBA G.S. TS 4076	Owner's Name: DAVID WHELELER Address: WYEMIA CURRABAWA SARABAWA Phone: SARABAWA
Current Occupant: Address: Phone:	
ACCESS	
Access Report of 5/1/1974 was found suitable/unsuitable. WINDLE TAKE ROAD TOWARDS HANGING ROCK. INTERSECTION HANGING ROCK, WINDLE & ADWENDOCK T. TAKE HANGING ROCK ROAD TAKE TRACK ON RIGHT, SHEEBA DAM ON LEFT. TURN RIGHT & THROUGH GATE SIGN "INVERARY" GREEN HOUSE ON RIGHT LOCKED GATE GATE POSTS HOUSE ON LEFT. QUEENSLAND GATE & RAILS LOGGING RAMP GO STRAIGHT UP HILL GO LEFT, PASS TRACK ON RIGHT. PASS FAINT TRACK ON RIGHT TURN SHARP LEFT, CLIMB ON TREE, FOLLOW TRACK THROUGH TIMBER. LEAVE VEHICLE, WALK UP ROCKY OUTCROP. 3 MIN WALK WITH LOAD * KEY FOR GATE FROM ABOVE ADDRESS BOOK SHOP POSSIBLY TAMWORTH	
Date	Record of Station
Date: Record of Station:	

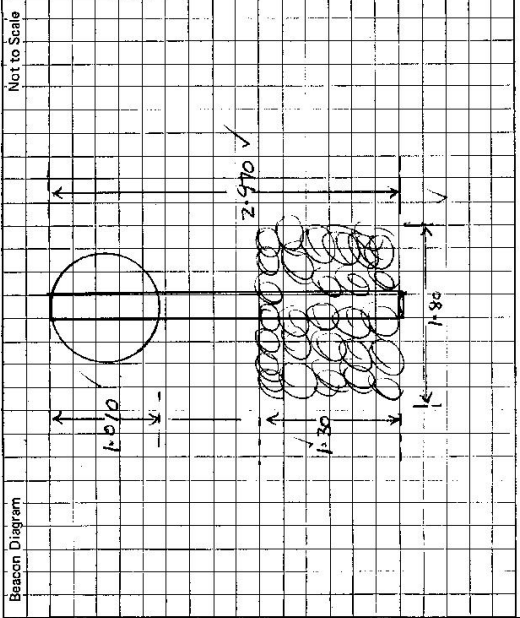

This section to be completed by officer constructing pillar.

Original station mark found/~~not found~~.

Description of mark: **AUST. SURVEY CORPS PLATON**

Original beacon found/~~not found~~.

Description of beacon: **CAIRN MARBLE & GRANITE**

Height Top of Vanes to Top Mark: **3.75** m. above G.L. below G.L.

Height of mark: **1.80** m. above G.L. below G.L.

Diameter of Vanes: **1.10** m. above G.L. below G.L.

Original Beacon has/~~has not~~ been destroyed by me.