

CENTRAL MAPPING AUTHORITY
Department of Lands

Trigonometrical Survey of N.S.W.

RECONNAISSANCE and MAINTENANCE REPORT

STATION *SHEEPSTATION* TS **4079**

This Trig. Station has been:-

Note: Cross out word or words which do not apply

1. Completely ~~renewed~~ ^{renewed bearing} 360° vision to surrounding Trigs.

2. Cleared by lanes bearing..... from Trig. Mast

3. Trig. Mast & Vanes have been painted white & black respectively.

4. The Trig. was unpiled/not unpiled, dimensions now being: _____

Description of mark..... should be explicit, e.g. Steel plug, Brass plug, Bolt, G.I. Pipe

Height of mark..... m above rock/concrete..... m below G.L.

Height of Top Vanes to Top Mark..... m. Diameter of Vanes (vertical)..... m.

Height of Cairn..... m. Diameter of Cairn..... m. ^{1.20 top} ~~2.00 base~~

Length of Mast..... m. (approximate if not unpiled)

- 5. A..... set in conc/rock has been placed..... m. bearing.....°M from Trig. Mast
- 6. A..... set in conc/soil has been placed..... m. bearing.....°M from Trig. Mast
- 7. A..... set in conc/soil has been placed..... m. bearing.....°M from Trig. Mast
- 8. A..... set in conc/rock has been placed..... m. bearing.....°M from Trig. Mast

9. Connection..... to..... m. bearing.....°M

10. Connection..... to..... m. bearing.....°M

11. Connection..... to..... m. bearing.....°M

12. Connection..... to..... m. bearing.....°M

13. Diff. Ht. is..... m. ^{above} ~~below~~

14. Diff. Ht. is..... m. ^{above} ~~below~~

15. Diff. Ht. is..... m. ^{above} ~~below~~

16. Diff. Ht. is..... m. ^{above} ~~below~~

Prepared by: _____

Checked: _____

Noted on U.T.M. Card

Co: *HAWES*

Map Sheet: *COWARRAL*

Inspected by: *M.L. Anderson*

Authority: _____


Ph: *70814*

No: *9335*

Date: *8-8-77*

Field Book: *1581*

Beacon Diagram Not to Scale

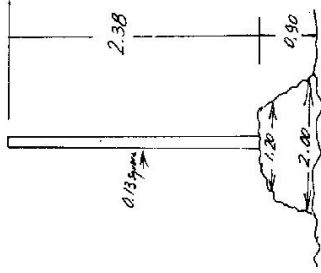

Date

Record of Station

TRIG. PD IN FINE CONVENTION CHAIN MAST ON 16 VANES. ALL LOWER CHAINS REQUIRED TO CLEAR FROM 180° to 180° + MAGN + MAY BE REQUIRED TO LAKE BETWEEN MAGN + 180°. ALL VERY O.K. TO JUST LAKE IF NEEDED. GOOD VIEW TO OTHER STATIONS & TABLES

Checked

