

GEODETIC SURVEY OF N.S.W.

CENTRAL MAPPING AUTHORITY

GEODETIC STATION RECONNAISSANCE and MAINTENANCE REPORT


STATION: **SHELLY** No.: **TS 4083**

MAP SHEET **Goulburn**
SCALE 1:250 000

INSPECTED BY: **A. Sivertsen** DATE: **3-11-78**

AUTHORITY: **C.M.A.** FIELD BOOK: **1709**

Description:
 1. Cleared by lanes bearing..... **Timbered 3.60**..... Note: Cross out word or words which do not apply
 2. Mast & Vanes have been painted white & black respectively. **Beacon in good condition**
 3. The station/pillar was ~~unpiled/constructed~~ on..... **19**....., dimensions now being:
 Description of mark..... should be explicit, e.g., S/Steel Pillar Plate, Steel plug, Brass plug, Bolt, G.I. Pipe
 Height of mark..... m. ^{above} rock/concrete; Mark is..... m. ^{above} G.L.
 Height of Top Vanes to Top ~~Mast/Pillar plate~~ **Cairn 2.20** m. Diameter of Vanes (vertical)..... **0.63** m.
 Height of Cairn..... **1.5** m. Diameter of Cairn..... **2.0** m. Name Plate ~~found/not found/placed~~.
 Length of Mast..... **3.7** t.m. (approximate if not unpiled)
 4. A..... set in conc/rock has been placed/found, bearing..... ° M from Mast/Plug/Pillar
 5. A..... set in conc/rock has been placed/found, bearing..... ° M from Mast/Plug/Pillar
 6. A..... set in conc/rock has been placed/found, bearing..... ° M from Mast/Plug/Pillar
 7. A..... set in conc/rock has been placed/found, bearing..... ° M from Mast/Plug/Pillar
 8. Action required..... **BUNGON/A.**
1:25,000

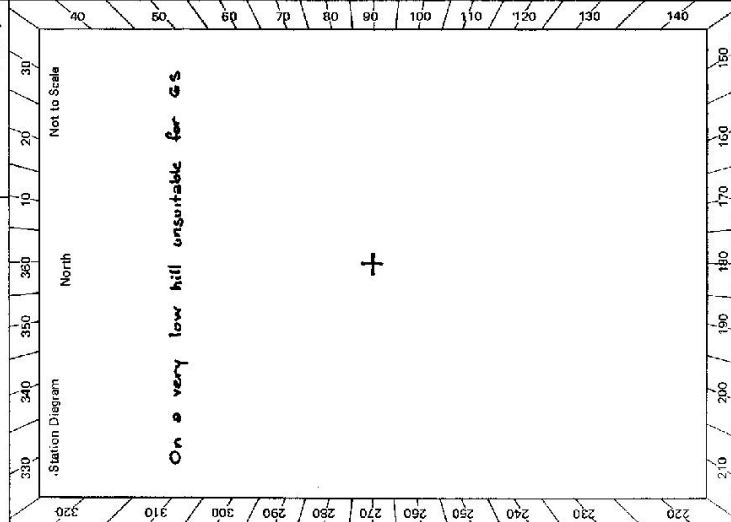


STANDPOINT:			
Mark	Direction	Horiz. Distance	Height Difference
			above standpt.
			below standpt.
			above standpt.
			below standpt.
Prepared by: *[Signature]* Checked: *[Signature]* Noted on U.T.M. Card

GS

STATION SHELLY TS 4083	Owner's Name: Mr Noel LANG Current Occupant: Address: 110 VICTORIA ST Address: Phone: (048) 211871 Phone: Phone: (048) 211871 Phone: ACCESS Access Report of 2.2.11/19.18 was found suitable/unavailable. Note: Phone or call owner for key to locked gate. About 18.9 km north of Southburn on Hume Hwy. turn Right into "WANDY" property. Old sandstone house. locked double gates near house. Take track straight ahead Gate Through iron gate on R then veer R towards creek Creek Through wooden gate then turn left along fence below first grove of th trees, then turn R up gully & go around second grove of trees & follow fence down to creek Through fence near creek of go up spur Cleared area — Δ on R end of ridge Δ SHELLY
--------------------------------------	--

Date Record of Station	
--	--

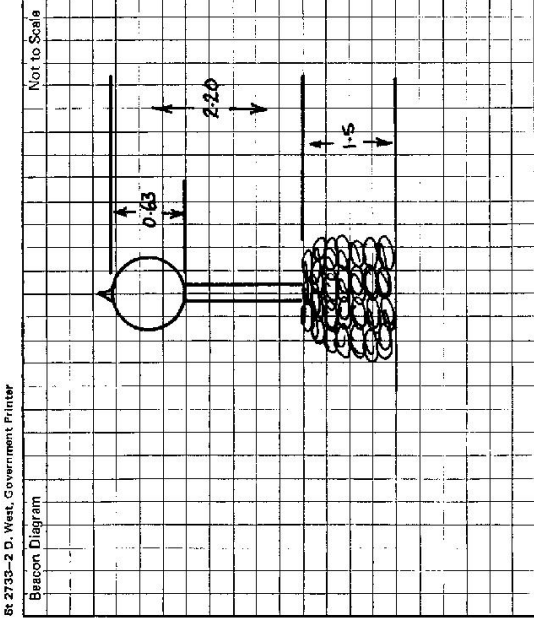

This section to be completed by officer constructing pillar.

Original station mark found/not found:

Description of mark:

Original beacon found/not found:

Description of beacon:

Height Top of Vanes to Top Markm.

Height of mark:m above G.L. /m below G.L.

Diameter of Vanesm. Height of Cairnm.

Original Beacon has/has not been destroyed by me.