

GEODETIC SURVEY OF N.S.W.

CENTRAL MAPPING AUTHORITY

GEODETIC STATION RECONNAISSANCE and MAINTENANCE REPORT

STATION: **SUMNERZ** No.: 15 **4086**

MAP SHEET SCALE 1:250 000 **Nelsons Bay**

INSPECTED BY: **M.L. Meneison** DATE: **Z6-10-78**

AUTHORITY: **CM.A.** FIELD BOOK: **1710**

Description: *Note: Cross out word or words which do not apply*

1. Cleared by lances bearing..... from Trig, Mast

2. Mast & Vanes have been painted white & black respectively.

3. The station/pillar was unpiled/not unpiled/constructed on....., dimensions now being:

Description of mark.....should be explicit, e.g., S/Steel Pillar Plate, Steel plug, Brass plug, Bolt, G.I. Pipe

Height of mark.....m. ^{above} rock/concrete; Mark is.....m. ^{above} G.L.

Height of Top Vanes to Top Mark/Pillar plate.....m. Diameter of Vanes (vertical).....m.

Height of Cairn.....m. Diameter of Cairn.....m. Name Plate found/not found/placed.

Length of Mast.....m. (approximate if not unpiled)

4. A.....~~set~~ in conc/rock has been placed/found, bearing.....° M from Mast/Plug/Pillar

5. A.....~~set~~ in conc/rock has been placed/found, bearing.....° M from Mast/Plug/Pillar

6. A.....~~set~~ in conc/rock has been placed/found, bearing.....° M from Mast/Plug/Pillar


7. A.....~~set~~ in conc/rock has been placed/found, bearing.....° M from Mast/Plug/Pillar

8. Action required:.....

STANDPOINT:							
Mark	Direction	Horiz. Distance	Height Difference	Mark	Direction	Horiz. Distance	Height Difference
			above standpt.				above standpt.
			below				below
			above standpt.				above standpt.
			below				below
Prepared by: *[Signature]* 16/11/78 Checked: *[Signature]* Noted on U.T.M. Card

SI 2733-1

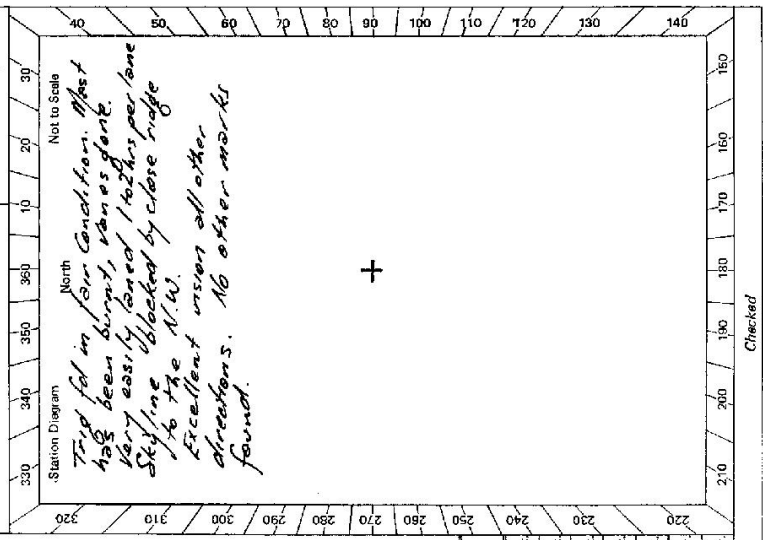

SF-2733-2 D. War, Government Printer

STATION **SHEPHERD TS 4086**


Owner's Name:
 Address:
 Phone:

Current Occupant:
 Address:
 Phone:

ACCESS

Access Report of **10/10/18** was found suitable/unsuitable.

Direction
 0.00 *Mission Rd. Head north along Home Hwy*
 1.20 *Turn left over grid improperly (start 100km speed limit sign)*
 1.30 *RH track Post house (Ouviers)*
 1.50 *Turn right past large foul shed*
 1.70 *Go through gate on main track next to shearing shed + yards*
 2.10 *GATE. TAKE R.H. track*
 2.75 *Gate*
 3.00 *Turn right up timber line*
 3.25 *Trig just into timber on right*

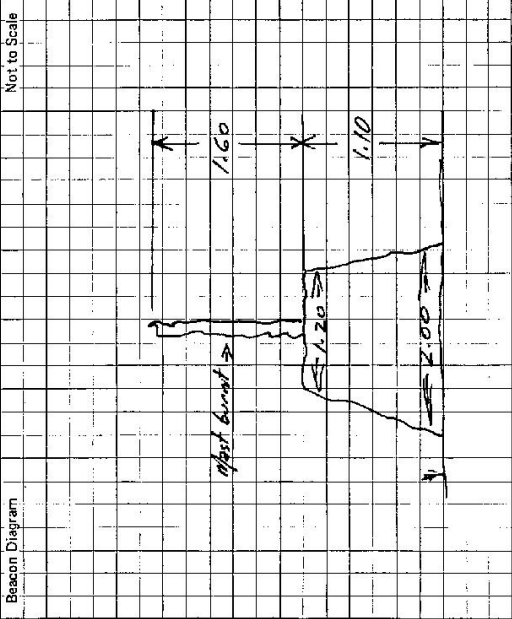

This section to be completed by officer constructing pillar.

Original station mark found/not found.

Description of mark:

Original beacon found/not found.

Description of beacon:

Height Top of Vanes to Top Mark.....m.

Height of mark.....m. above G.L. below

Diameter of Vanesm. Height of Cairnm.

Original Beacon has/has not been destroyed by me.

Date	Record of Station