

GEODETTIC SURVEY OF N.S.W.

CENTRAL MAPPING AUTHORITY

GEODETTIC STATION RECONNAISSANCE and MAINTENANCE REPORT

STATION: SHOOTERS HILL No.: 4092

MAP SHEET SCALE 1:250 000 BATHURST

INSPECTED BY: G. C. HANNJA DATE: 2 / 4 / 79

AUTHORITY: C. M. A. FIELD BOOK:

- Description:
1. Cleared by lanes bearing. *Note: Cross out word or words which do not apply.*
2. Mast & Vanes have been painted white & black respectively.
3. The station/pillar was unplied/not unplied/constructed on.....m. *19.....m. dimensions now being:*
- Description of mark.....should be explicit, e.g., S/Steel Pillar Plate, Steel plug, Brass plug, Bolt, G.I. Pipe
- Height of mark.....m. ^{above} rock/concrete; Mark.....m. ^{above} G.L.
- Height of Top Vanes to Top Mark/Pillar plate.....m. Diameter of Vanes (vertical).....m.
- Height of Cairn.....m. Diameter of Cairn.....m. Name Plate found/not found/placed.
- Length of Mast.....m. (approximate if not unplied)
4. A.....set in conc./rock has been placed/found, bearing.....° M from Mast/Plug/Pillar
5. A.....set in conc./rock has been placed/found, bearing.....° M from Mast/Plug/Pillar
6. A.....set in conc./rock has been placed/found, bearing.....° M from Mast/Plug/Pillar
7. A.....set in conc./rock has been placed/found, bearing.....° M from Mast/Plug/Pillar
8. Action required:.....

STANDPOINT:


Mark	Direction	Horiz. Distance	Height Difference	Mark	Direction	Horiz. Distance	Height Difference
			above standpt.				above standpt.
			below				below
			above standpt.				above standpt.
			below				below
Checked

Checked:

Prepared by: *G. C. Hannja* 27/6/79

51 2758-1

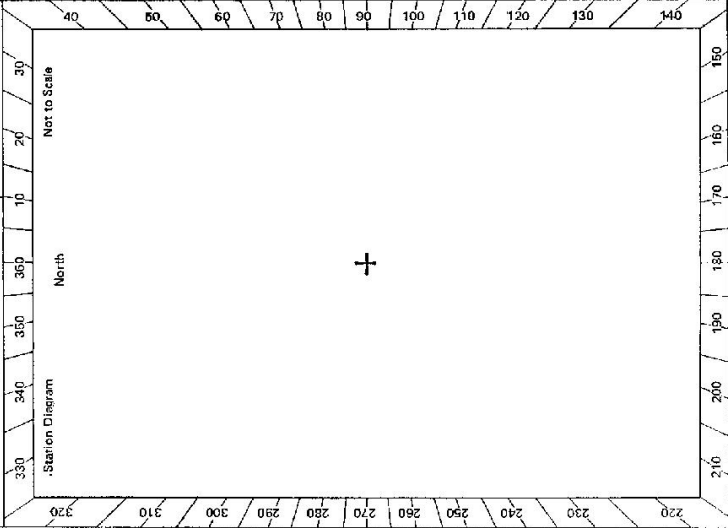

GS

St 2733-2.D. West, Beacon Diagram	STATION SHOOTER S HILL TS 4092	Owner's Name: Address: Phone: Current Occupant: Address: Phone: ACCESS Access Report of 8.5.19.79 was found suitable/unsuitable. Oberon about 24km Drive to trig. Cairn, most 2 vanes found in good condition Vision obstructed by pine plantation from about 1350 to 900 For further information see Shooters Hill 8830-11-S
This section to Original station mark found/not found. Description of mark: Original beacon found/not found. Description of heacon: Height Top of Vanes to Top Markm. Height of markm. above G.L. Diameter of Vanesm. below Height of Cairnm. Original Beacon has/has not been destroyed by me.	Date Record of Station	not to Scale 