

CENTRAL MAPPING AUTHORITY

GEODETIC SURVEY OF N.S.W.

GEODETIC STATION RECONNAISSANCE and MAINTENANCE REPORT


STATION: **SINCLAIR** No.: **TS 4099**

MAP SHEET SCALE 1:250 000 **CANBERRA**

INSPECTED BY: **W. MILLER** DATE: **27.11.78**

AUTHORITY: FIELD BOOK:

- Description:
1. Cleared by lanes bearing..... *Heavy Timber*..... from Trig. Mast
Note: Cross out word or words which do not apply
 2. Mast & Vanes have been painted white & black respectively.
 3. The station/pillar was ~~supported~~/not unplied/constructed on..... **27.11.1977**....., dimensions now being:
Description of mark..... should be explicit, e.g., S/Steel Pillar Plate, Steel plug, Brass plug, Bolt, G.I. Pipe
Height of mark.....m. ^{above} rock/concrete; Mark is.....m. ^{above} G.L.
 - Height of Top Vanes to Top Mark/Pillar plate.....m. Diameter of Vanes (vertical).....m.
 - Height of Cairn.....**1.3**.....m. Diameter of Cairn.....**2**.....m. Name Plate found/not found/placed.
 - Length of Mast.....**4.1**.....m. (approximate if not unplied)
 4. A.....set in conc/rock has been placed/found, bearing.....° M from Mast/Plug/Pillar
 5. A.....set in conc/rock has been placed/found, bearing.....° M from Mast/Plug/Pillar
 6. A.....set in conc/rock has been placed/found, bearing.....° M from Mast/Plug/Pillar
 7. A.....set in conc/rock has been placed/found, bearing.....° M from Mast/Plug/Pillar
 8. Action required:.....

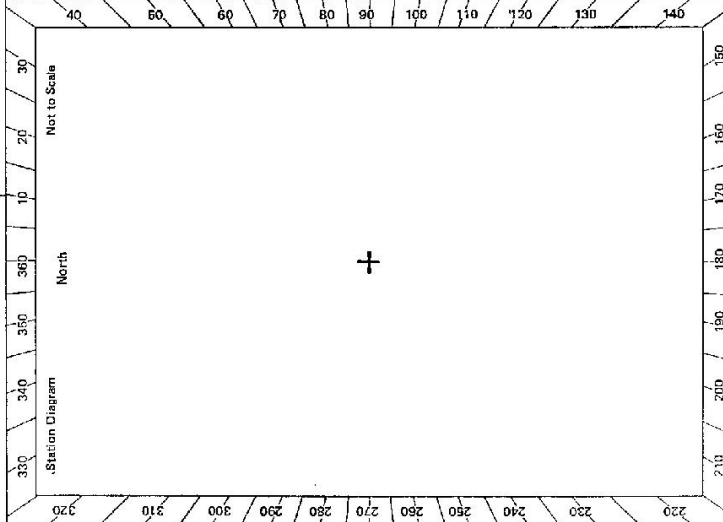

STANDPOINT:

Mark	Direction	Horiz. Distance	Height Difference	Mark	Direction	Horiz. Distance	Height Difference
			above standpt				above standpt
			below standpt				below standpt
			above standpt				above standpt
			below standpt				below standpt
Prepared by: *W. Miller*

18.12.78

Checked: *W. Miller*

Checked

<p>STATION SINCLAIR TS 4099</p> <p>Owner's Name:</p> <p>Address:</p> <p>Phone:</p> <p>Current Occupant:</p> <p>Address:</p> <p>Phone:</p> <p>Access Report of 27.11.1978 was found suitable/unsuitable</p>	<p>Scale 1:25,000</p> <p>20 min Walk</p> <p>Sinclair TS</p> <p>Molonglo River</p> <p>Klonker Post</p> <p>ACCESS</p> <p>10 Footway</p> <p>Dirt Road</p> <p>Stop</p> <p>20 min Walk</p> <p>10 Carriars</p> <p>Flat</p> <p>DFSI</p> <p>Record of Station</p>
<p>Beacon Diagram</p> <p>Not to Scale</p>	<p>This section to be completed by officer constructing pillar.</p> <p>Original station mark found/not found.</p> <p>Description of mark:</p> <p>Original beacon found/not found.</p> <p>Description of beacon:</p> <p>Height Top of Vanes to Top Markm.</p> <p>Height of markm. above G.L. below rock/concm.</p> <p>Diameter of Vanesm. Height of Cairnm.</p> <p>Original Beacon has/has not been destroyed by me.</p>
<p>Date 27.11.78</p> <p>27.11.78</p> <p>Diurnal L.R.M.C.</p>	