

7498

CENTRAL MAPPING AUTHORITY
 Department of Lands
 Trigonometrical Survey of N.S.W.
 RECONNAISSANCE and MAINTENANCE REPORT

STATION **SKELETAR T.S. 4104**
 Co: **DURHAM** Pk: **ROWAN**
 Map Sheet: **Muswellbrook** No: **9033**
 Inspected by: **H. Border** Date: **July 1973**
 Authority: **C.M.A.** Field Book: **—**

This Trig. Station has been:-
 Note: Cross out word or words which do not apply

1. Completely cleared to permit 360° vision to surrounding Trigs.
2. Cleared by lanes bearing from Trig. Mast
3. Trig. Mast & Vanes have been painted white & black respectively.
4. The Trig. was unpiled/not unpiled, dimension now being:

Description of mark should be explicit, e.g. Steel plug, Brass plug, Ball, G.I. Pipe
 Height of mark m above rock concrete m below G.L.
 Height of Top Vanes to Top Mark m. Diameter of Vanes (vertical) m.
 Height of Cairn m. Diameter of Cairn m.

5. A set in conc./rock has been placed m. bearing°M from Trig. Mast
6. A set in conc./soil has been placed m. bearing°M from Trig. Mast
7. A set in conc./soil has been placed m. bearing°M from Trig. Mast
8. A set in conc./rock has been placed m. bearing°M from Trig. Mast


9. Connection to m. bearing°M
10. Connection to m. bearing°M
11. Connection to m. bearing°M
12. Connection to m. bearing°M

13. Diff. Ht. is m. above below
14. Diff. Ht. is m. above below
15. Diff. Ht. is m. above below
16. Diff. Ht. is m. above below

Prepared by: *[Signature]* Checked: *[Signature]*

Noted on U.T.M. Card *Kelly* *18-12-74* Checked *[Signature]*

Beacon Diagram Not to Scale
 A steel observing pillar has been placed on the platform that is erected over the ground mark. Pillar is directly over the old trig. plug

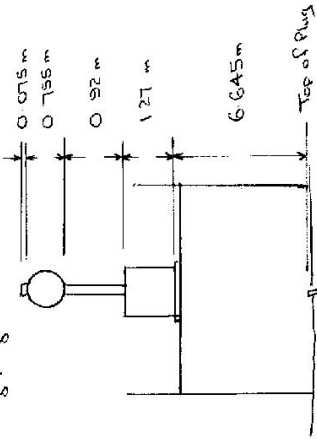


Date

Record of Station

STATION SKELETAR TS 4104	
Owners Name..... Address..... Access.....	Current Occupant..... Address..... Access.....
Not to Scale	
List of Observed Directions:-	
Standpoint: Copper Nail in Conc.	Standpoint:
Station Direction Station	Station Direction
Arthur T.S. 389° 39' 60"	Station Direction
This Plug 181° 36' 40"	Station Direction
Delville T.S. 18° 29' 25"	Station Direction
Station Direction Station	Station Direction
Station Direction Station	Station Direction
Station Direction Station	Station Direction


GS 24

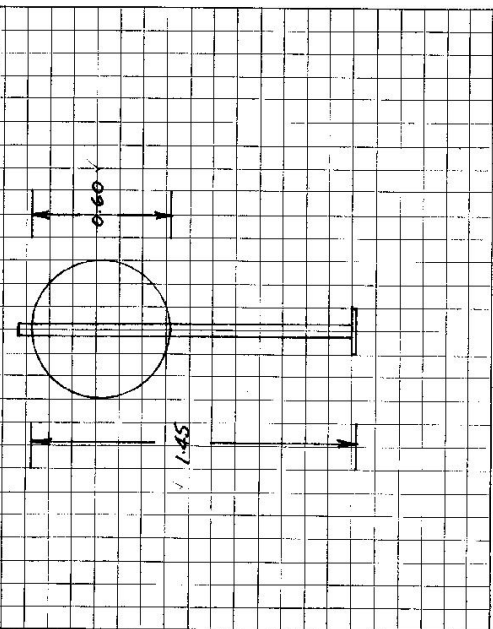STATION SKELETAR G.S. (P) TS 4104	Owner's Name: Address: Phone: Current Occupant: Address: Phone: Access Report of/19.....was found suitable/unuitable. <p style="text-align: center;">ACCESS</p>
Beacon Diagram Not to Scale	 <p>This section to be completed by officer constructing pillar.</p> Original station mark found/not found. Description of mark: Original beacon found/not found. Description of beacon: Height Top of Vanes to Top Markm. Height of markm. above rock/concm. below G.L. Diameter of Vanesm. Height of Cairnm. Original Beacon has/has not been destroyed by me.
Date 15.2.78	Record of Station Placed on new metal vanes

STATION **SKELE AR (P) TS 4104**

Owners Name.....
 Current Occupant.....
 Address.....
 Address.....

Access 6-1-1976
 on Al Muswellbrook on New England Hwy at Hill at
 chance along common Rd.
 37 locked iron gate (key from PMS Muswellbrook)
 47 TS

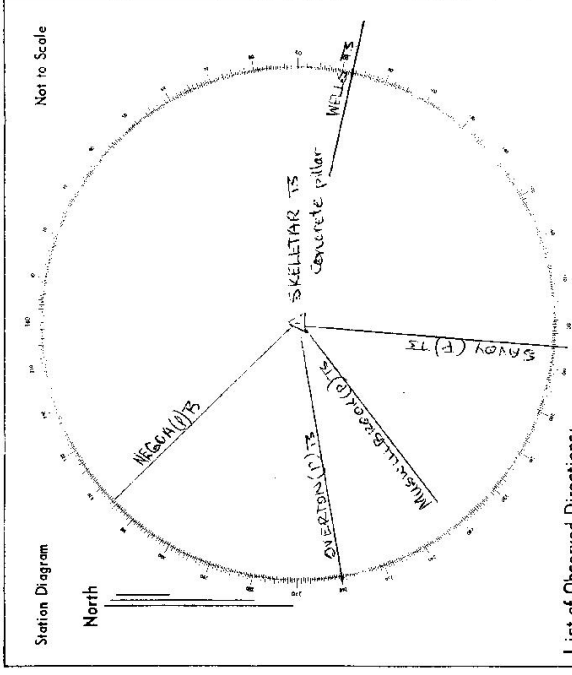

List of Observed Directions:-

Standpoint: PMS AR		Station:	
Station	Direction	Station	Direction
WELLS TS	0° 40' 00"		
SANDY (F) TS	81° 51' 00"		
MUSWELLBROOK (P) TS	130° 15' 37"		
ONERTON (P) TS	153° 20' 31.8"		
NEESDA (P) TS	205° 41' 49.1"		
Station	Direction	Station	Direction