

GEODETTIC SURVEY OF N.S.H.

CENTRAL MAPPING AUTHORITY

GEODETTIC STATION RECONNAISSANCE and MAINTENANCE REPORT


STATION: **SMALLEY** No.: **13 4110**

MAP SHEET SCALE 1:250 000 **CANBERRA**

INSPECTED BY: **H.C. BORDER** DATE: **7-12-78**

AUTHORITY: **C.M.A** FIELD BOOK: **O14.11**

- Description:
- Note: Cross out word or words which do not apply
1. Cleared by lanes bearing **W.S.** **TIMBERED** **from Trig. Mast**
100 to bearing will take, normally round gun tower,
 2. Mast & Vanees have been painted white & black respectively.
 3. The station/letter was ~~applied~~/not applied/~~constructed~~ on..... 19....., dimensions now being:
Description of mark. **not found** should be explicit, e.g., S/Steel Pillar Plate, Steel plug, Brass plug, Bolt, G.I. Pipe
Height of mark.....m. above rock/concrete; Mark is.....m. above G.L.
Height of Top Vanees to Top Mark/Pillar plate.....m. oak, Diameter of Vanees (vertical).....m.
TOWER 1-000 Top
Height of Centre.....m. Diameter of Centre.....m. Name Plate found/not found/~~placed~~.
Length of Mast.....m. (approximate if not applied)
 4. A..... **MARKS, FB**..... set in conc/rock has been placed/found, bearing.....° M from Mast/Plug/Pillar
 5. A..... set in conc/rock has been placed/found, bearing.....° M from Mast/Plug/Pillar
 6. A..... set in conc/rock has been placed/found, bearing.....° M from Mast/Plug/Pillar
 7. A..... set in conc/rock has been placed/found, bearing.....° M from Mast/Plug/Pillar
 8. Action required: **top of tower not reached, need a ladder to reach top**.....

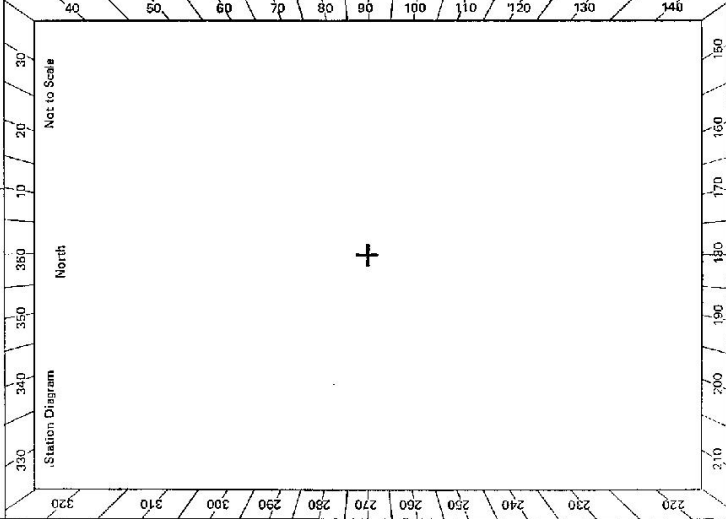

STANDPOINT:


Mark	Direction	Horiz. Distance	Height Difference	Mark	Direction	Horiz. Distance	Height Difference
			above standpt				above standpt
			below				below
			above standpt				above standpt
			below				below
Prepared by: **H.C. Border**

Checked: **H.C. Border**

Noted on U.T.M. Card

68

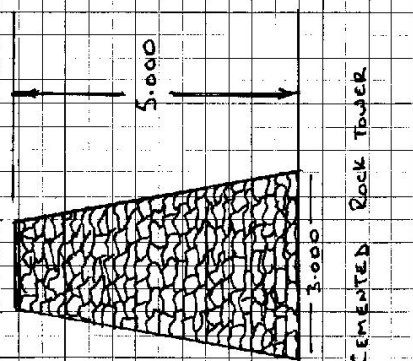STATION SMALLEY TS 4110	<table style="width:100%; border-collapse: collapse;"> <tr> <td style="width: 30%;"> Owner's Name: NOT KNOWN Address: Phone: </td> <td style="width: 30%;"> Current Occupant: Address: Phone: </td> <td style="width: 40%; vertical-align: top;"> ACCESS Access Report of 7.12.18 was found suitable/unsuitable. from Cross roads at Bungendore, - Queanbeyan + Goulburn - Gundaroo 0.00 km take Gundaroo road, turn off onto lake road R.H.S at 3.40' through gate at 8.10' across grid "DOUGLAS" at 9.10' through grid + gate HOMESTEAD on L.H.S at 9.20' follows track to big white house, drive around L.H.S of stables + through gate at 9.50' turn hand left and look for pipe crossing over ditch (may be hidden in long grass) straight ahead + through gate at 9.60' steep climb, paving down on R.H.S of track at 10.30' T junction in tracks turn right at 10.50' follow track along ridge Rock Tower on L.H.S. just off track at 11.20' </td> </tr> </table>	Owner's Name: NOT KNOWN Address: Phone:	Current Occupant: Address: Phone:	ACCESS Access Report of 7.12.18 was found suitable/unsuitable. from Cross roads at Bungendore, - Queanbeyan + Goulburn - Gundaroo 0.00 km take Gundaroo road, turn off onto lake road R.H.S at 3.40' through gate at 8.10' across grid "DOUGLAS" at 9.10' through grid + gate HOMESTEAD on L.H.S at 9.20' follows track to big white house, drive around L.H.S of stables + through gate at 9.50' turn hand left and look for pipe crossing over ditch (may be hidden in long grass) straight ahead + through gate at 9.60' steep climb, paving down on R.H.S of track at 10.30' T junction in tracks turn right at 10.50' follow track along ridge Rock Tower on L.H.S. just off track at 11.20'
Owner's Name: NOT KNOWN Address: Phone:	Current Occupant: Address: Phone:	ACCESS Access Report of 7.12.18 was found suitable/unsuitable. from Cross roads at Bungendore, - Queanbeyan + Goulburn - Gundaroo 0.00 km take Gundaroo road, turn off onto lake road R.H.S at 3.40' through gate at 8.10' across grid "DOUGLAS" at 9.10' through grid + gate HOMESTEAD on L.H.S at 9.20' follows track to big white house, drive around L.H.S of stables + through gate at 9.50' turn hand left and look for pipe crossing over ditch (may be hidden in long grass) straight ahead + through gate at 9.60' steep climb, paving down on R.H.S of track at 10.30' T junction in tracks turn right at 10.50' follow track along ridge Rock Tower on L.H.S. just off track at 11.20'		
Beacon Diagram Not to Scale	 <p style="text-align: center;">CEMENTED ROCK TOWER</p>			
This section to be completed by officer constructing pillar. Original station mark found /not found. Description of mark: Original beacon found/ not found . Description of beacon: ROCK CEMENTED TOWER Height Top of Vanes to Top Markm. Height of markm. above G.L. / belowm. Diameter of Vanesm. Height of Cairnm. Original Beacon was has not been destroyed by me.				
Date	Record of Station			