


7.5 10

Department of Lands

RECONNAISSANCE and MAINTENANCE REPORT

Integrat. survey of N.S.W.

STATION TS 4115 BUNBURY CUMBERLAND
 Co: CUMBERLAND Ph: MINTO
 Map Sheet: MINTO 1:10 000 No: 8230
 Inspected by: C STARKEY Date: 21/8/19
 Authority: LANDS DEPT. Field Book: 1A05

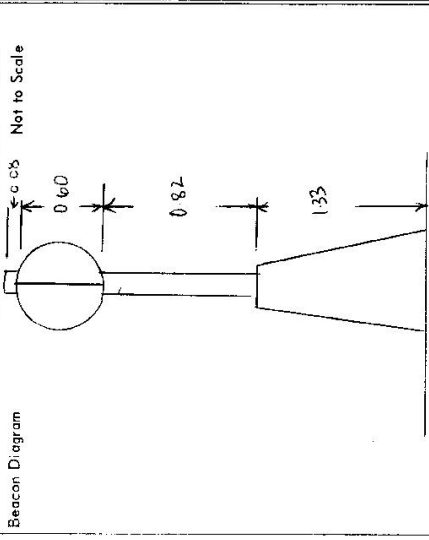

This Trig. Station has been:-

Note: Cross out word or words which do not apply

- 1. Completely cleared to permit 360° vision to surrounding Trigs.
- 2. Cleared by lanes bearing
- 3. Trig. Mast & Vanes have been painted white & black respectively.
- 4. The Trig. was unpiled/~~not supported~~, dimensions now being:

Description of mark: Concrete Pillar should be explicit, e.g. Steel plug, Brass plug, Bolt, Concrete Pillar

Height of mark: 1.33 m above ~~below~~ rock/concrete m above G.L.

Height of Top Vanes to ~~Top Mark~~/Top pillar plate: 1.42 m Diameter of Vanes (vertical): 0.60 m.

Height of Cairn: m. Diameter of Cairn: m.

Length of Mast: m. (approximate if not unpiled)

- 5. A. ~~Copper spike~~ set in conc/~~rock~~ has been placed/~~to~~ 3.526 m. bearing 234°M from Trig. ~~Mast~~/pillar
- 6. A. ARMY PLAQUE set in conc/~~soil~~ has been placed/~~to~~ 3.036 m. bearing 294°M from Trig. ~~Mast~~/pillar
- 7. A. set in conc/soil has been placed/~~to~~ m. bearing°M from Trig. Mast/pillar
- 8. A. set in conc/rock has been placed/~~to~~ m. bearing°M from Trig. Mast/pillar
- 9. Connection Copper spike to Army plaque : 3.311 m. bearing 11°M
- 10. Connection: to: m. bearing°M
- 11. Connection: to: m. bearing°M
- 12. Connection: to: m. bearing°M
- 13. Diff. Ht. COPPER SPIKE is 1.562 m. below PILLAR PLATE
- 14. Diff. Ht. ARMY PLAQUE is 1.433 m. below " "
- 15. Diff. Ht. is m. above
- 16. Diff. Ht. is m. above

Date	Record of Station
	<u>Previously called Smiths</u>

Prepared by: C STARKEY Checked: [Signature]

STATION TS 4115 BUNBURY CO-PLAN

Owners Name.....

Current Occupant.....


Address.....

Access 21-8-79


FROM CROSS ROADS AT LIVERPOOL TAKE CAMPBELLTOWN RD TO ST ANDREWS.

TAKE ST ANDREWS RD ON RIGHT, FOLLOW TO Y JUNCTION AND TAKE ST JAMES RD ON RIGHT, FOLLOW TO Y JUNCTION AND TAKE ST DAVIDS RD ON RIGHT FOLLOW FOR 100M TO LETTERBOX NO 2A ON RIGHT (SEE SKETCH)

(SEE SKETCH)

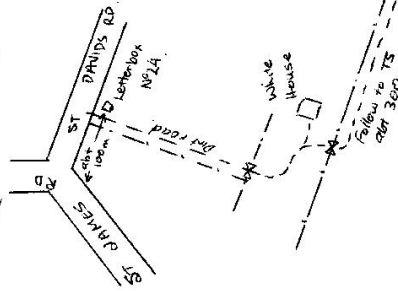

Station Diagram Not to Scale

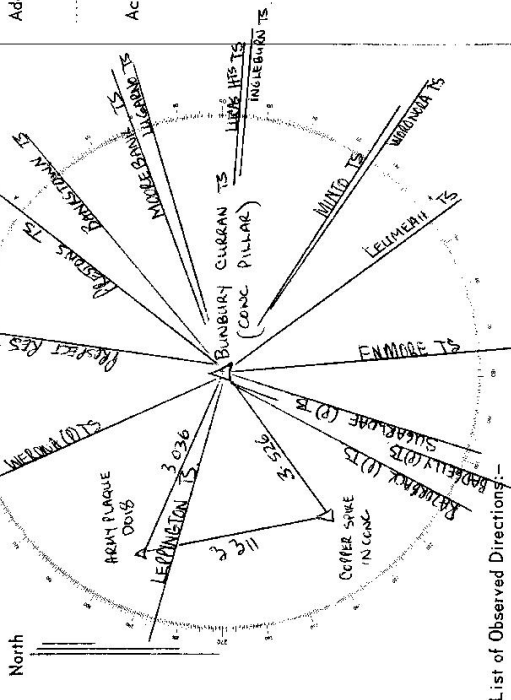

List of Observed Directions:

Station	Direction	Station	Direction
PRESTONS TS	338 90 00	PILLAR	0 00 00
BANKSTOWN TS	50 21 20 0	RASC PLAQUE	307 20 52
COPPER SPIKE	233 57 49 4		
RASC PLAQUE (DO18)	243 54 38 9		

Station	Direction	Station	Direction

CENTRAL MAPPING AUTHORITY

Department of Lands

Trigonometrical Survey of N.S.W.

RECONNAISSANCE and MAINTENANCE REPORT

This Trig. Station has been:-

Note: Cross out word or words which do not apply

- 1. Completely cleared to permit 360° vision to surrounding Trigs.
- 2. Cleared by lanes bearing..... from Trig. Mast
- 3. Trig. Mast & Vanes have been painted white & black respectively.
- 4. The Trig. was unpiled/not unpiled, dimensions now being: m. above below G.L. ~~..... m. above below G.L. m. above below~~

Description of mark..... should be explicit, e.g. Steel plug, Brass plug, Bolt, G.I. Pipe

Height of mark..... m. above below rock/concrete m. above below G.L.

Height of Top Vanes to Top Mark..... m. Diameter of Cairn..... m.

Height of Cairn..... m. Diameter of Cairn..... m.

Length of Mast..... m. (approximate if not unpiled)

- 5. A..... set in conc/rock has been placed..... m. bearing.....°M from Trig. Mast
- 6. A..... set in conc/soil has been placed..... m. bearing.....°M from Trig. Mast
- 7. A..... set in conc/soil has been placed..... m. bearing.....°M from Trig. Mast
- 8. A..... set in conc/rock has been placed..... m. bearing.....°M from Trig. Mast

- 9. Connection..... to..... m. bearing.....°M
- 10. Connection..... to..... m. bearing.....°M
- 11. Connection..... to..... m. bearing.....°M
- 12. Connection..... to..... m. bearing.....°M
- 13. Diff. Ht. is..... m. above below
- 14. Diff. Ht. is..... m. above below
- 15. Diff. Ht. is..... m. above below
- 16. Diff. Ht. is..... m. above below

Prepared by: [Signature] 3/11/77 Checked: [Signature]

Noted on U.T.M. Card

STATION BUNBURY 4115


Co: ASHBURNHAM Ph: BUNBURY

Map Sheet: PARKES No: 8531 14IV

Inspected by: N. MORTON Date: NOVEMBER 1977

Authority: Field Book: Net to Scale

Beacon Diagram

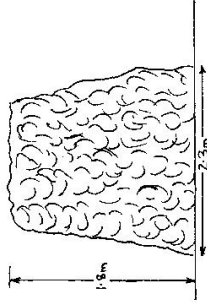


Date	Record of Station

Checked

STATION **BUNBURY** 4115

Owners Name.....
 Current Occupant.....
 Address.....
 Address.....
 Access.....

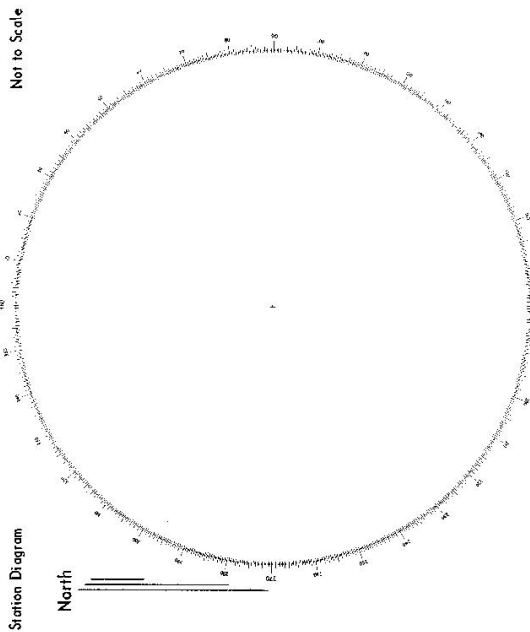

List of Observed Directions:-

Standpoint:	
Station	Direction

Standpoint:	
Station	Direction

