

GEODETTIC SURVEY OF N.S.W.

CENTRAL MAPPING AUTHORITY


GEODETTIC STATION RECONNAISSANCE and MAINTENANCE REPORT

STATION: SPARROW (ACT) No.: 4141

MAP SHEET SCALE 1:250 000 CANBERRA

INSPECTED BY: W MILLER DATE: 12-5-78

AUTHORITY: CMA FIELD BOOK:

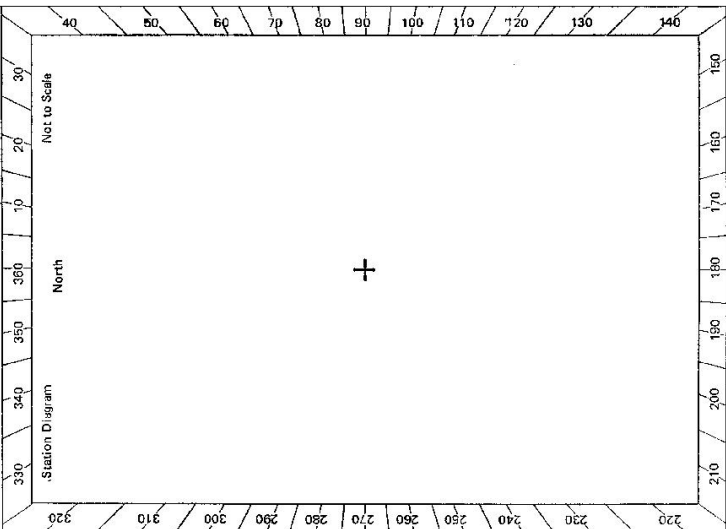

- Description:
- Cleared by lanes bearing 120° to 40° from Trig. Mast. Note: Cross out word or words which do not apply
 - Mast & Vanes have been painted white & black respectively.
 - The station/pillar was unpiled/hot unpiled/constructed on 19....., dimensions now being: Description of mark.....should be explicit, e.g., S/Steel Pillar Plate, Steel plug, Brass plug, Bolt, G.I. Pipe
- Height of mark.....m. above/below rock/concrete; Mark is.....m. above/below G.L.
- Height of Top Vanes to Top Mark/Pillar plate.....m. Diameter of Vanes (vertical).....m.
- Height of Cairn.....m. Diameter of Cairn.....m. Name Plate found/not found/placed.
- Length of Mast.....m. (approximate if not unpiled)
- A.....set in conc/rock has been placed/found, bearing..... $^{\circ}$ M from Mast/Plug/Pillar
 - A.....set in conc/rock has been placed/found, bearing..... $^{\circ}$ M from Mast/Plug/Pillar
 - A.....set in conc/rock has been placed/found, bearing..... $^{\circ}$ M from Mast/Plug/Pillar
 - A.....set in conc/rock has been placed/found, bearing..... $^{\circ}$ M from Mast/Plug/Pillar
8. Action required:.....

STANDPOINT:							
Mark	Direction	Horiz. Distance	Height Difference	Mark	Direction	Horiz. Distance	Height Difference
			above standpt.				above standpt.
			below standpt.				below standpt.
			above standpt.				above standpt.
			below standpt.				below standpt.
			above standpt.				above standpt.
			below standpt.				below standpt.
			above standpt.				above standpt.
			below standpt.				below standpt.

Prepared by: W Miller Checked: Noted on U.T.M. Card


GS 24

STATION **SPARROW (ACT) IS 414**

Owner's Name: **KOWEN FOREST**
 Address: **DEPOT 1'S OFF**
SUTTON ROAD NEAR QUAMBOYAN
 Phone: **12-5-1978**

Current Occupant:
 Address:
 Phone:


ACCESS

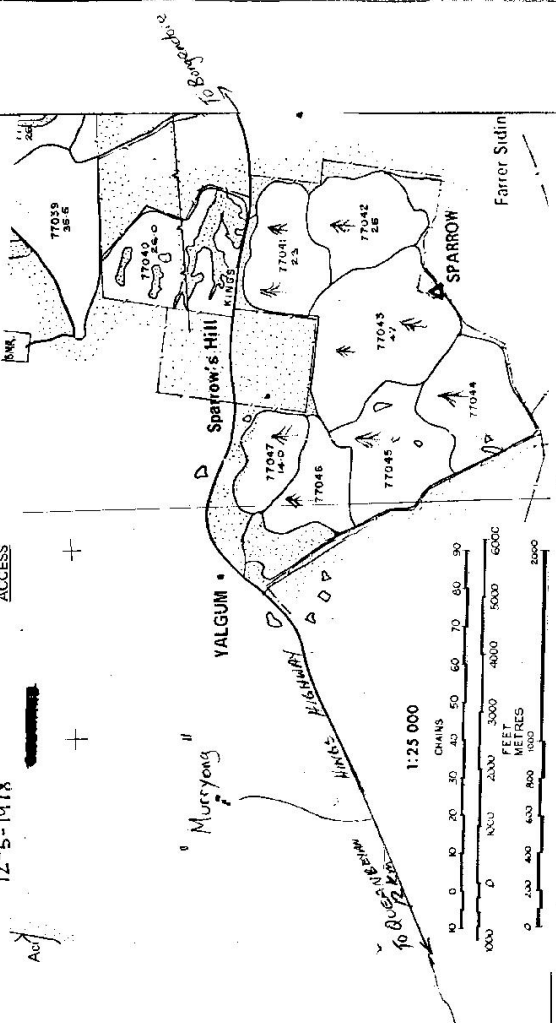

Record of Station

Date

Sr 2733-2 D. West, Government Printer

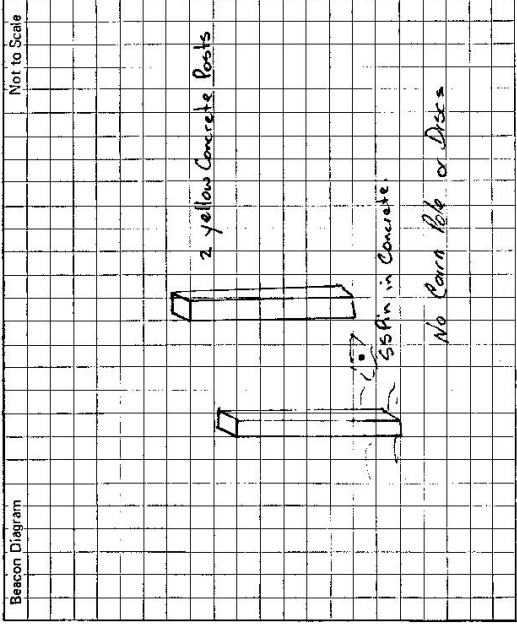

This section to be completed by officer constructing pillar.

Original station mark found/not found.

Description of mark:

Original beacon found/not found.

Description of beacon:

Height Top of Vanes to Top Mark:m.

Height of mark:m. above G.L.
m. below

Diameter of Vanesm.

Height of Calmm.

Original Beacon has/has not been destroyed by me.