

STATION SPICER TS 4144

Owners Name: J.P. STEPHENS... Current Occupant:

Address: "B road water." Address:

FLADBURY

Access 26-8-1975

Keys 0-0

0-8 Royal Hotel GLEN INNES heading West

1-1 Level Crossing

2-2 Turn RIGHT towards 'AIRPORT'

Pass 'BONSHAW' turn off on L.H.S.


28-9 Turn RIGHT onto gravel road through double iron gates

31-0 Through iron gate

31-5 Owners house on L.H.S. Turn RIGHT onto wheel tracks

31-8 6 pl. 1/2 b. fence, blazed stringybark tree, Trig is about a 15 min. walk from here in a southerly direction.

S. Manners 4-8-75

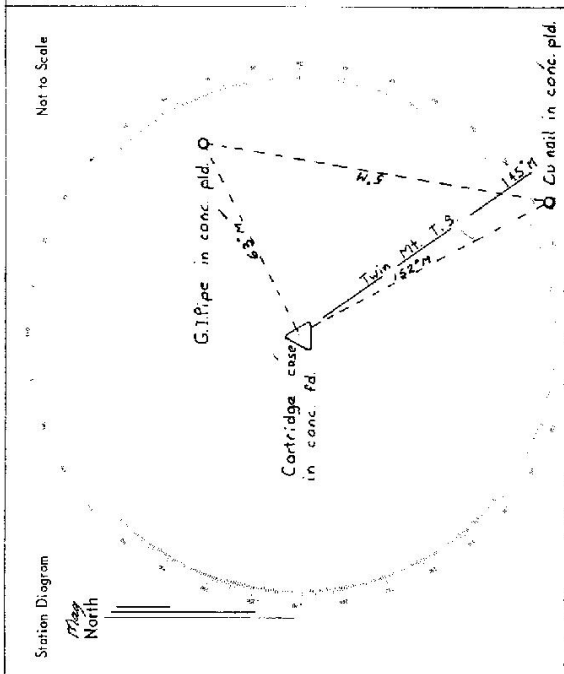

List of Observed Directions:-

Station	Direction	Station	Direction
TWIN MT. T.S.	0° 00' 00"	TWIN MT. T.S.	0° 00' 00"
Cu nail in conc. pld.	5° 58' 30"	Cu nail in conc. pld.	38° 21' 30"
G.I. Pipe in conc. pld.	279° 03'	Trig. plug cart. case in conc. pld.	99° 02'
Cu nail in conc. pld.			
TWIN MT. T.S.	0° 00' 00"		
Trig. plug cart. case	185° 55' 00"		
G.I. Pipe in conc. pld.	318° 30' 00"		

GEOBETIC SURVEY OF N.S.W.

CENTRAL MAPPING AUTHORITY


GEODETTIC STATION RECONNAISSANCE and MAINTENANCE REPORT

STATION: **SPICER** No.: **TS 4144**

MAP SHEET SCALE 1:250 000 **Griffon**

INSPECTED BY: **J. Kinlyrick** DATE: **Aug 178**

AUTHORITY: **CHM 67/2/2** FIELD BOOK: **-**

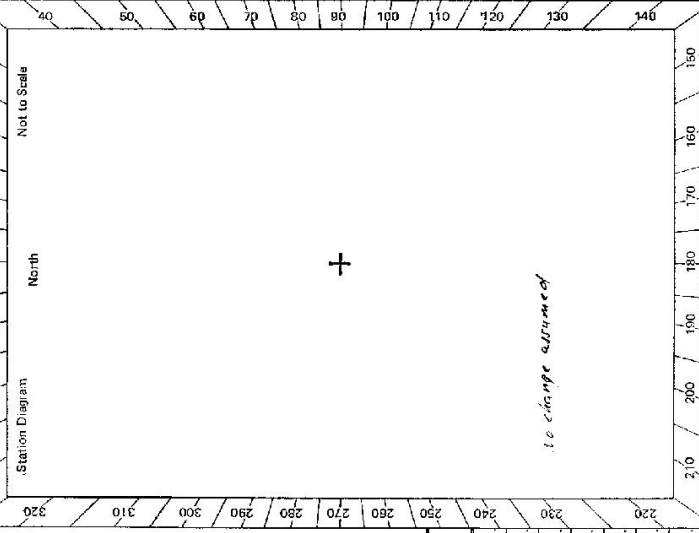

Mark	Direction	Horiz. Distance	Height Difference	Mark	Direction	Horiz. Distance	Height Difference
			above standpt.				above standpt.
			below				below
			above standpt.				above standpt.
			below				below
Description: *Cleared* Note: Cross out word or words which do not apply

1. Cleared by Janes bearing..... *Cleared*..... from Trig. Mast

2. Mast & Vanes have been painted white & black respectively. *not visible. It appears in order from road*

3. The station/~~plate~~ was ~~unpiled~~/*unpiled*/constructed on..... 19....., dimensions now being:

Description of mark.....should be explicit, e.g., S/Steel Pillar Plate, Steel plug, Brass plug, Bolt, G.I. Pipe

Height of mark.....m. ^{above} _{below} rock/concrete; Mark is.....m. ^{above} _{below} G.L.

Height of Top Vanes to Top Mark/Pillar plate.....m. Diameter of Vanes (vertical).....m.

Height of Cairn.....m. Diameter of Cairn.....m. Name Plate found/not found/placed.

Length of Mast.....m. (approximate if not unpiled)

4. A.....set in conc/rock has been placed/found, bearing.....° M from Mast/Plug/Pillar

5. A.....set in conc/rock has been placed/found, bearing.....° M from Mast/Plug/Pillar

6. A.....set in conc/rock has been placed/found, bearing.....° M from Mast/Plug/Pillar

7. A.....set in conc/rock has been placed/found, bearing.....° M from Mast/Plug/Pillar

8. Action required: *Pending investigation of alternative access, it may be suitable for piling.....*

STANDPOINT:

Prepared by: *h. Palmer 9/1/78* Checked: *h. Palmer 9/1/78* Noted on U.T.M. Card


St 2735-2 D. West. Government Printer

STATION *SPICER TS 4144*

Owners Name *J.A. STEPHENS*
 Address *B road water*
 Current Occupant
 Address
FLADBURGH

Access *Aug 1978*
 Kms.
 0-0 *Royal Hotel GLEN INNES heading West*
 0-8 *Level Crossing*
 1-1 *Turn RIGHT towards 'AIRPORT'*
 2-2 *Pass 'BONSHAW' turn off on L.H.S.*
 28-9 *Turn RIGHT onto gravel road through double iron gates*
 31-0 *Through iron gate*
 31-5 *Owners house on L.H.S. Turn RIGHT onto wheel track*
 31-8 *6 pl. 1/2 lb. fence, blazed stringybark tree, Trig. is about 45 mins walk from here in a southerly direction.*

S. Manners 6-8-75

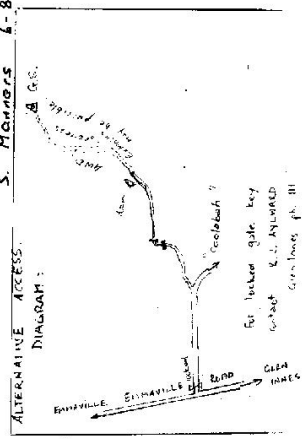

Beacon Diagram	Not to Scale
<i>Advised no change since 25/1/75</i>	

This section to be completed by officer constructing pillar.

Original station mark found/not found.

Description of mark:

Original beacon found/not found.

Description of beacon:

Height Top of Vanes to Top Mark:m.

Height of mark:m. above G.L. below

Diameter of Vanesm. Height of Cairnm.

Original Beacon has/has not been destroyed by me.