

GEODEIC SURVEY OF N.S.W.

CENTRAL MAPPING AUTHORITY


GEODEIC STATION RECONNAISSANCE and MAINTENANCE REPORT

STATION: **SQUARE HEAD G.S.** No.: **TS 4155**

MAP SHEET SCALE 1:250 000

INSPECTED BY: **J. STOLEMA** DATE: **14.9.78**

AUTHORITY: **CENTRAL MAPPING** FIELD BOOK: **1692**

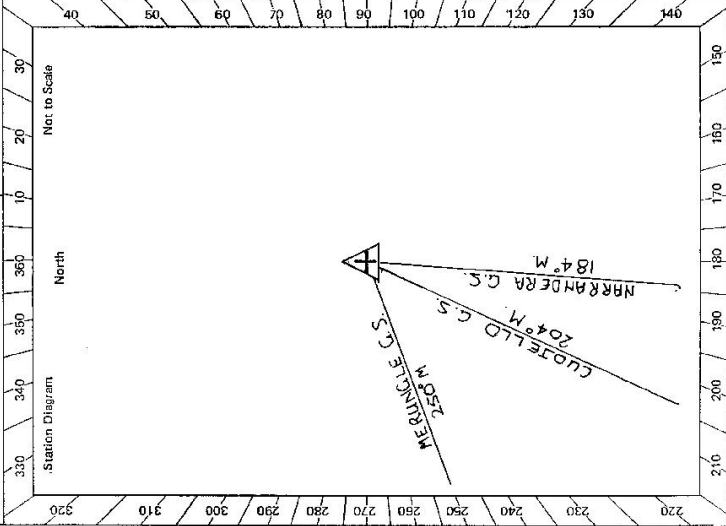

- Description:
1. Cleared by lanes bearing.....
Note: Cross out word or words which do not apply
2. ~~Mast & Vanes have been painted white & black respectively.~~
3. The station/pillar was unspiled/not unspiled/constructed on.....**14.9.78**....., dimensions now being:
- Description of mark.....**Steel Pillar-Plate, Steel plug, Brass plug, Bolt, G.L. Pipe**.....
 Height of mark.....**0.03**.....m. ^{above} rock/concrete; Mark is.....**0.03**.....m. ^{above} G.L.
- Height of Top Vanes to Top Mark/Pillar-plate.....**4.4**.....m. Diameter of Vanes (vertical).....**0.92**.....m.
- Height of Cairn.....**4.4**.....m. Diameter of Cairn.....**2.08**.....m. **Name Plate-found/not found/placed.**
- Length of Mast.....**1.53**.....m. (approximate if not unspiled)
4. A.....**set in conc/rock has been placed/found, bearing.....° M from Mast/Plug/Pillar**
5. A.....**set in conc/rock has been placed/found, bearing.....° M from Mast/Plug/Pillar**
6. A.....**set in conc/rock has been placed/found, bearing.....° M from Mast/Plug/Pillar**
7. A.....**set in conc/rock has been placed/found, bearing.....° M from Mast/Plug/Pillar**
8. Action required:.....**Needs to be cleared for 360° M. vision.**.....

STANDPOINT:			
Mark	Direction	Horiz. Distance	Height Difference
			above standpt.
			below
			above standpt.
			below
Prepared by: *[Signature]* Checked: *[Signature]*

Noted on U.T.M. Card

St 2735-2 D. West, Government Printer

01

<p>STATION SQUARE HEAD G.S. IS 4155</p>	<p>Owner's Name: Address: Phone:</p> <p>Current Occupant: Address: Phone:</p> <p style="text-align: center;">ACCESS</p> <p>Access Report of <u>14/9/1978</u> was found suitable/unsuitable.</p> <p>Key to locked gate cannot be obtained at County Council office at Narrandera. - Instead at Rice Board Office in LEETON. or property owners at Square Head. Property name "Square Nobs"</p>
<p>Beacon Diagram</p>	
<p>Not to Scale</p>	<p>This section to be completed by officer constructing pillar.</p> <p>Original station mark found/not found.</p> <p>Description of mark:</p> <p>Original beacon found/not found.</p> <p>Description of beacon:</p> <p>Height Top of Vanes to Top Mark.....m. above G.L. below</p> <p>Height of mark.....m. above G.L. below</p> <p>Diameter of Vanesm. Height of Cairnm.</p> <p>Original Beacon has/has not been destroyed by me.</p>
	<p>Date</p> <p>Record of Station</p>