

CENTRAL MAPPING AUTHORITY

GEODETIC SURVEY OF N.S.W.

GEODETIC STATION RECONNAISSANCE and MAINTENANCE REPORT

Description:

Note: Cross out word or words which do not apply

1. Cleared by lanes bearing..... from Trig. Mast
2. Mast & Vanes have been painted white & black respectively.
3. The station/pillar was unpiled/not unpiled/constructed on.....19....., dimensions now being: Description of mark.....should be explicit, e.g., S/Steel Pillar Plate, Steel plug, Brass plug, Bolt, G.I. Pipe
Height of mark.....m. ^{above} rock/concrete; Mark is.....m. ^{above} G.L.
- Height of Top Vanes to Top Mark/Pillar platem. Diameter of Vanes (vertical).....m.
- Height of Cairn.....m. Diameter of Cairn.....m. Name Plate found/not found/placed.
- Length of Mastm. (approximate if not unpiled)
4. A.....set in conc/rock has been placed/found, bearing.....° M from Mast/Plug/Pillar
5. A.....set in conc/rock has been placed/found, bearing.....° M from Mast/Plug/Pillar
6. A.....set in conc/rock has been placed/found, bearing.....° M from Mast/Plug/Pillar
7. A.....set in conc/rock has been placed/found, bearing.....° M from Mast/Plug/Pillar
8. Action required:.....

STANDPOINT:

STANDPOINT:

Mark	Direction	Horiz. Distance	Height Difference	Mark	Direction	Horiz. Distance	Height Difference
			above standpt				above standpt
			below				below
			above standpt				above standpt
			below				below
Prepared by: K. Haddad April 1978

Checked: Noted on U.T.M. Card

SI 2733-1

STATION: STEEL No.: TS 4172

MAP SHEET SCALE 1:250 000 FORBES

INSPECTED BY: K. Haddad DATE: March 1978

AUTHORITY: C.M.A. FIELD BOOK:

Station Diagram

North

Not to Scale

Checked


SI 2733-2 D. West, Government Printer

STATION STEEL JS 4172

Owner's Name:
 Address:
 Phone:

Current Occupant:
 Address:
 Phone:

March 1978
ACCESS
 Access Report of/...../19.....was found suitable/unsuitable.
 From Conkolobin take Forbes Road on South side of Leachlan River.
 00 Conkolobin.
 27 Turn right.
 48 Cross roads Turn left towards Forbes
 54.8 Turn right through gate.
 55.2 Cross irrigation channel.
 58.0 Gate
 61. straight ahead ("Dungernan" homestead on left.)
 61.2 Turn right around sheds
 63 Hill on left. Find own way to bottom of hill. Approach from eastern side may be better. About 5 min walk to trig from western side.

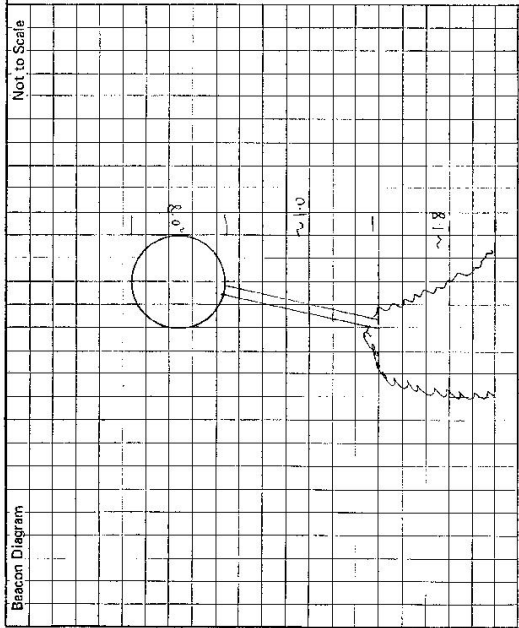

This section to be completed by officer constructing pillar.

Original station mark found/not found.
 Description of mark:
 Original beacon found/not found.
 Description of beacon:
 Height Top of Vanes to Top Mark.....m.
 Height of mark.....m. above G.L. below
 Diameter of Vanesm. Height of Cairnm.
 Original Beacon has/not been destroyed by me.

Date
 March 1978
 Record of Station
 Mark and Vanes leaning.