

GEODETTIC SURVEY OF M.S.R.

CENTRAL MAPPING AUTHORITY

GEODETTIC STATION RECONNAISSANCE and MAINTENANCE REPORT

Description:

- Note: Cross out word or words which do not apply
- Cleared by lanes bearing Tress of 57-67, 81-90, 144-147, 215-222, 243 from Trig. Mast
  - ~~Mast & Vanes have been painted white & black respectively:~~
  - The station/pillar was ~~unspiled/constructed~~ on 19 m, dimensions now being: Description of mark — should be explicit, e.g., S/Steel Pillar Plate, Steel plug, Brass plug, Bolt, G.I. Pipe  
Height of mark — m, above rock/concrete; Mark is — m, above G.L.
  - Height of Top Vanes to Top Mark/Pillar plate — m. Diameter of Vanes (vertical) 0.93 m.
  - Height of Cairn 0.8 m. Diameter of Cairn 2.7 m. Name Plate found/not found/placed.
  - Length of Mast — m. (approximate if not unspiled)
  - A — set in conc/rock has been placed/found, bearing — ° M from Mast/Plug/Pillar
  - A — set in conc/rock has been placed/found, bearing — ° M from Mast/Plug/Pillar
  - A — set in conc/rock has been placed/found, bearing — ° M from Mast/Plug/Pillar
  - A — set in conc/rock has been placed/found, bearing — ° M from Mast/Plug/Pillar

Action required: HANWORTH  
1:25,000

STANDPOINT:			
Mark	Direction	Horiz. Distance	Height Difference
			above standpt.
			below standpt.
			above standpt.
			below standpt.
Prepared by: [Signature] Checked: [Signature] Noted on U.T.M. Card

STATION: **ST. PAULS** No.: **4191**

MAP SHEET SCALE 1:250 000 **Wollongong**

INSPECTED BY: **A. Sivertsen** DATE: **20-11-78**

AUTHORITY: **CMA** FIELD BOOK: **1717**

Station Diagram North Not to Scale

**Broken mast of vanes on ground.**  
**↳ 2.7 approx top cairn.**


**Close Δ's visible**  
**NUNDIALLA Δ 131°M**  
**BULLIO Δ**  
**PENANG (Hill)**  
**HANNIBAL Δ**  
**MOORAGEE (Hill)**  
**+ ones on Δ card.**

**Excellent Δ site**  
**↳ extensive 360° views**

Checked

Sr 2733-2 D. West, Government Printer

STATION **ST. PAULS TS 4191**

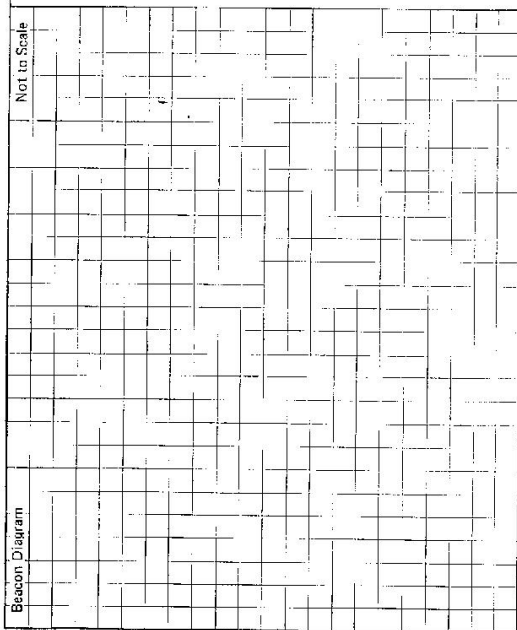

Owner's Name: **CROWAN TR 157**  
 Address: .....  
 Phone: .....  
 Current Occupant: .....  
 Address: .....  
 Phone: .....

**ACCESS**

Access Report of 28.11.1978 was found suitable (unsat) table.

From **TARALGA** take **BUNNABY** road for 19.5 km to intersection about 300m after church.

- 0.0 Intersection - Take road to L towards "Hornworth"
- 4.3 Pass yards on L
- 5.85 Turn R through gate "No 8" opposite fridge "Summer Hill" then turn R down fence and through another gate
- 5.9 At second gate - follow track to L.
- 6.4 Gate
- 7.35 Gate follow track to L
- 7.8 Passing ruins in saddle
- 8.0 Take R fork around side of hill
- 8.2 End of track. Make own way up hill
- 8.5 10 min walk to **ST. PAULS A.**

↳ a negotiable way may be found by moving a few rocks.

This section to be completed by officer constructing pillar.

Original station mark found/not found.

Description of mark: .....

Original beacon found/not found.

Description of beacon: .....

Height Top of Vanes to Top Mark.....m.

Height of mark.....m. above G.L. below

Diameter of Vanes .....m. Height of Cairn .....m.

Original Beacon has/not been destroyed by me.

Date .....

Height of Station .....