

CENTRAL MAPPING AUTHORITY

GEODETIC SURVEY OF N.S.W.

GEODETIC STATION RECONNAISSANCE and MAINTENANCE REPORT

- Description:
- Cleared by lances bearing, cleared 360 from Trig. Mast
 - ~~Mast & Vanes have been painted white & black respectively.~~
 - The station/pillar was unpiled/not unpiled/constructed on 19 dimensions now being: Description of mark, should be explicit, e.g., S/Steel/Pillar Plate, Steel plug, Brass plug, Bolt, G.I. Pipe
 - Height of mark, m, above/below rock/concrete; Mark is m, above/below G.L.
 - Height of Top Vanes to Top Mark/Pillar plate m, Diameter of Vanes (vertical) m.
 - Height of Cairn, m, Diameter of Cairn, m, Name Plate found/not found/placed.
 - Length of Mast, m, (approximate if not unpiled)
 - A, set in conc/rock has been placed/found, bearing, ° M from Mast/Plug/Pillar
 - A, set in conc/rock has been placed/found, bearing, ° M from Mast/Plug/Pillar
 - A, set in conc/rock has been placed/found, bearing, ° M from Mast/Plug/Pillar
 - A, set in conc/rock has been placed/found, bearing, ° M from Mast/Plug/Pillar

TARALGA
1:25,000

STANDPOINT:

Mark	Direction	Horiz. Distance	Height Difference	Mark	Direction	Horiz. Distance	Height Difference
			above standpt.				above standpt.
			below standpt.				below standpt.
			above standpt.				above standpt.
			below standpt.				below standpt.
Prepared by: *[Signature]* Checked: *[Signature]*

Noted on U.T.M. Card

STATION: STRATHAIRD No.: TS 4193
 MAP SHEET SCALE 1:250 000 Goulburn
 INSPECTED BY: A. Sivertsen DATE: 21-11-78
 AUTHORITY: CMA FIELD BOOK: 1717

Station Diagram North
 Collapsed cairn found.
 Vanes on ground 0.93 m
 Blocked by close ridge 120-165 (Recess) 345-355 (abt 3km)
 View limited to abt 10km to E
 Macalister Δ 275m
 +
 Good Δ if central required here
 Extensive views from 0-120m


2:0 200 300 400 500 600 700 800 900 1000 1100 1200 1300 1400
 320 330 340 350 360 370 380 390 400

Net to Scale

91 2733-1

8c-2753-2 D. West, Government Printer

Beacon Diagram

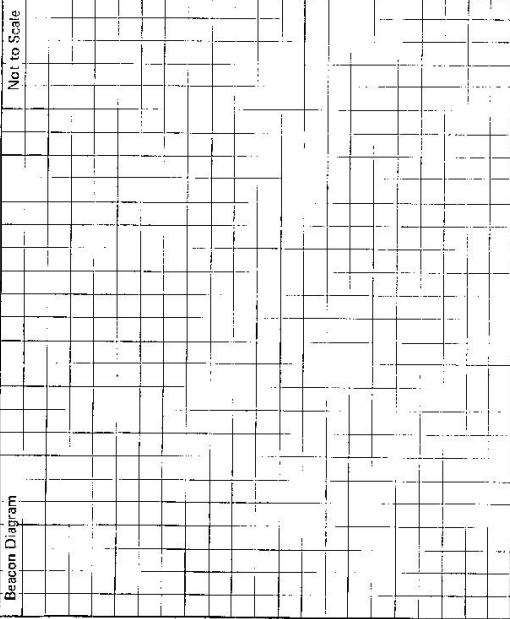

This section to be completed by officer constructing pillar.

Original station mark found/not found.

Description of mark:

Original beacon found/not found.

Description of beacon:

Height Top of Vanes to Top Mark.....m.

Height of mark.....m. above rock/conc.....m. above G.L. below

Diameter of Vanesm. Height of Cairn.....m.

Original Beacon has/has not been destroyed by me.

STATION STRATHAIRD TS 4193

Owner's Name: Current Occupant:

Address: Address:

Phone: Phone:

Note LOCKED GATE
ACCESS
Access Report of 21/11/1978 was found suitable/unsuitable.

From main intersection of southern end of TARALGA take
GOULBURN road for 7.7 km then turn L over grid near pine trees.

- 0.0 Grid
- 2.9 Turn R
- 3.7 Pass track on R
- 4.4 " " "
- 4.9 Gate - take L Fork
- 6.4 Gate - go straight ahead towards shed
- 6.5 Gate 1 yards on L
- 6.7 Gate
- 7.4 LOCKED GATE Bush Fire M23 Key From CTS
△ is 200 m on R

Date

Report of Station

CENTRAL MAPPING AUTHORITY

GEODETIC SURVEY OF N.S.W.

GEODETIC STATION RECONNAISSANCE and MAINTENANCE REPORT

- Description: 3100° Note: *Cross out word or words which do not apply*
- Cleared ~~by~~ 3100° *from Trig. Mast*
 - Mast & Vanes have been painted white & black respectively, X 100° *found*
 - The station/~~marker~~ found was ~~unplaced~~ found unplaced/~~corrected~~ found on 28 June 1984, dimensions now being: Description of mark Brass G.I. Pillar should be explicit, e.g., S/Steel Pillar Plate, Steel plug, Brass plug, Bolt, G.I. Pipe
Height of mark 0.50 m. above rock/~~corrected~~; Mark is 1.50 m. ~~above~~ below G.L.
Height of Top Vanes to Top Mark/Pillar plate m. Diameter of Vanes (vertical)..... 93 m.
Height of Cairn..... m. Diameter of Cairn..... m. Name Plate ~~found~~/~~not found~~/~~placed~~.
Length of Mast m. (approximate if not unplaced)
 - A..... set in conc/rock has been placed/~~found~~, bearing.....° M from Mast/Plug/Pillar
 - A..... set in conc/rock has been placed/~~found~~, bearing.....° M from Mast/Plug/Pillar
 - A..... set in conc/rock has been placed/~~found~~, bearing.....° M from Mast/Plug/Pillar
 - A..... set in conc/rock has been placed/~~found~~, bearing.....° M from Mast/Plug/Pillar
 - Action required:

STANDPOINT:		STANDPOINT:				
Mark	Direction	Horiz. Distance	Height Difference	Direction	Horiz. Distance	Height Difference
			above standpt			above standpt
			below			below
			above standpt			above standpt
			below			below
Prepared by: D. J. Kain Checked: 11/2 Noted on U.T.M. Card

