

CENTRAL MAPPING AUTHORITY

GEODETIC SURVEY OF N.S.W.

GEODETIC STATION RECONNAISSANCE and MAINTENANCE REPORT

Description:

1. Cleared by lanes bearing..... *Note: Cross out word or words which do not apply*

2. Mast & Vanes have been painted white & black respectively. *no beacon*

3. The station/pillar was unpiled/not unpiled/constructed on.....19....., dimensions now being:

Description of mark.....should be explicit, e.g., S/Steel Pillar Plate, Steel plug, Brass plug, Bolt, G.I. Pipe

Height of mark.....m, above below rock/concrete; Mark is.....m, above below G.L.

Height of Top Vanes to Top Mark/Pillar plate.....m. Diameter of Vanes (vertical).....m.

Height of Cairn.....m. Diameter of Cairn.....m. Name Plate found/not found/placed.

Length of Mast.....m. (approximate if not unpiled)

4. A.....set in conc/rock has been placed/found, bearing.....°M from Mast/Plug/Pillar

5. A.....set in conc/rock has been placed/found, bearing.....°M from Mast/Plug/Pillar

6. A.....set in conc/rock has been placed/found, bearing.....°M from Mast/Plug/Pillar

7. A.....set in conc/rock has been placed/found, bearing.....°M from Mast/Plug/Pillar

8. Action required.....

TOWRANG

1:25,000

STANDPOINT:

STANDPOINT:

Mark	Direction	Horiz. Distance	Height Difference	Mark	Direction	Horiz. Distance	Height Difference
			above standpt				above standpt
			below				below
			above standpt				above standpt
			below				below
Checked:

Noted on U.T.M. Card

Prepared by:

ST 2733-1

STATION: STRATHFIELD		No.: TS 4195	
MAP SHEET SCALE 1:250,000		Gaulburn	
INSPECTED BY: A. Sivertsen		DATE: 10-10-78	
AUTHORITY: CMA		FIELD BOOK: 1642	

Station Diagram

North

Not to Scale

△ site on very low area - useless as G.S.

△ site in ploughed paddock no mark found.

- was beaconed until "recently" but no sign remains


+

Reca. for RELEGATION

S: 2733-2 D. West, Government Printer

STATION		STRAATHFIELD	TS 4195
<p>Owner's Name: <u>MR. ROBIN ORLANDO</u></p> <p>Address: <u>CL MANAGER</u></p> <p>Phone:</p>	<p>Manager Current Occupant: <u>MR. TREVOR APPE</u></p> <p>Address: <u>"RIVER GLEN"</u></p> <p>Phone: <u>TOWRANG VIA GOULBURN</u></p>	<p style="text-align: center;"><u>ACCESS</u></p> <p>Access Report of <u>10/10/1978</u> was found suitable/unsuitable.</p> <p><u>0.0</u> Goulburn P.O. Take Hwy north</p> <p><u>9.0</u> Boxers Ck</p> <p><u>10.7</u> Turn L. Sealed road to GREENWICH PARK</p> <p><u>12.0</u> B TOWRANG</p> <p><u>14.7</u> Rly bridge</p> <p><u>Δ</u> site on R.</p>	
<p style="text-align: center;">This section to be completed by officer constructing pillar.</p> <p>Original station mark found/not found.</p> <p>Description of mark:</p> <p>Original beacon found/not found.</p> <p>Description of beacon:</p> <p>Height Top of Vane to Top Mark.....m.</p> <p>Height of mark.....m. above G.L. below</p> <p>Diameter of Vane.....m. Height of Cairn.....m.</p> <p>Original Beacon has/not been destroyed by me.</p>			
Date		Record of Station	

Department of Lands		Integral Survey of N.S.W.		RECONNAISSANCE and MAINTENANCE REPORT 4195		STATION STRATHFIELD TS 4195	
This Trig. Station has been:-				Co: ARGYLE		Ph: NERRING	
1. Completely cleared to permit 360° vision to surrounding trigs.				Map Sheet: C101 RUEN		No: 8828	
2. Cleared by lanes bearing. U.M. 7.180° M				Inspected by: P HARCUMRE		Date: 18/3/83	
3. Trig. Mast & Vanes have been painted white & black respectively.				Authority: INTEGRATION SURVEYS		Field Book: 7561/9	
4. The Trig. was unspiled/not unspiled, dimensions now being:-				Beacon Diagram		Not to Scale	
Description of mark..... <u>BLASS PLUG</u> should be explicit, e.g. Steel plug, Brass plug, Ball, Concrete Pillar				NO BEACON ERECTED			
Height of mark..... <u>0.02</u> m above <u>steel</u> concrete..... <u>0.3</u> m above G.L.							
Height of Top Vanes to Top Mark/Top pillar plate..... m Diameter of Vanes (vertical)..... m.							
Height of Cairn..... m. Diameter of Cairn..... m.							
Length of Mast..... m. (approximate if not unspiled)							
5. A..... set in conc./rock has been placed/fd..... m. bearing..... °M from Trig. Mast/pillar				<div style="text-align: center;"> <p>NO REFERENCE BEACON PLACED</p> <p>NO REFERENCE BEACON PLACED</p> </div>			
6. A..... set in conc./soil has been placed/fd..... m. bearing..... °M from Trig. Mast/pillar							
7. A..... set in conc./soil has been placed/fd..... m. bearing..... °M from Trig. Mast/pillar							
8. A..... set in conc./rock has been placed/fd..... m. bearing..... °M from Trig. Mast/pillar							
9. Connection..... to..... m. bearing..... °M							
10. Connection..... to..... m. bearing..... °M							
11. Connection..... to..... m. bearing..... °M							
12. Connection..... to..... m. bearing..... °M							
13. Diff. Ht. is..... m. above below							
14. Diff. Ht. is..... m. above below							
15. Diff. Ht. is..... m. above below							
16. Diff. Ht. is..... m. above below							
Prepared by: <u>P.R. Harcumre</u> Checked:							

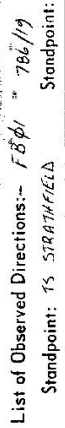

Station	Direction	Station	Direction
MATTERY	178° 00' 00"		
P.M. 60244	127° 36' 58"		
P.M. 60243	147° 51' 41"		

18/3/1980

Access
IRIG PLUG IS IN A CULTIVATED PADDOCK, APPROXIMATELY 20 METRES
EAST OF SOME EXISTING TREES. THERE ARE SOME REMAINS
OF MAST AND VANES IN A SMALL DEPRESSION WHICH CONTAINS THE
TRIG AND HAVE NOT BEEN PLOUGHED. THERE IS A LAUND DIRT
PADDOCK ON GATE MARKED "X" ON ATTACHED SHEET BELOW.

