

STATION SUB-LIME TS 4209P.

Original Station Established by _____ Date 7-8-87 Order _____

DATUM: Australian Geodetic Datum 1966, on 6,378,160 metres; 11 = 288 25; Johnston Origin Adjustment No: V
 RECTANGULAR CO-ORDINATES: Australian Map Grid, in Metres
 Grid Bearing = Adj. Azimuth + Convergence. HEIGHT: A.M.D. in metres _____

Map Name: MOILONGONG Scale 1: _____
 Map Number: _____ Parish: SOUTH LAND
 County: CLARENDON Aerial Photographs: _____
 Plan Reference: _____


Station Diagram

TO	ADJ AZIMUTH	ADJ LENGTH	SOUTH LATITUDE	EAST LONGITUDE	ZONE	EASTING	NORTING	CONVERGENCE

Field Book _____ Description Book _____
 Abstract Book _____ Bearing of Triangulation Book _____
 Date _____ Marking and Description of Station _____ Reference _____

Station Mark: STEEL PILLAR
 Bench: MAST & VANES
 Erection Height: 11.250 TOP VANES TO TOP PILING PLATE

Station (last visited) (Year) _____ Date _____
 Amended _____ Date _____
 Amended _____ Date _____

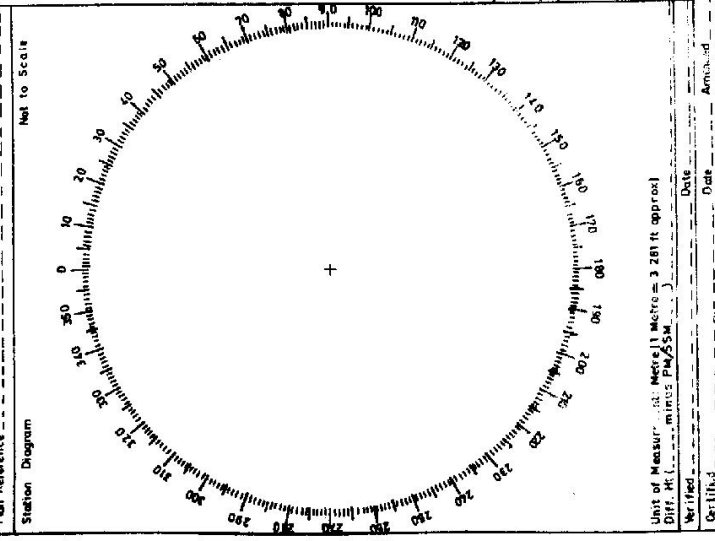

DEPARTMENT OF LANDS

EN 2733-2-B, West, Government Printer

Beacon Diagram		Not to Scale
Height of Top Vanes to Top Mark/Pillar plate	1.435	m.
Diameter of Vanes (vertical)	0.750	m.
Notes	Max. Max 2 Vanes Above Sublime 2000 1.1m 2.1m	
This section to be completed by officer constructing pillar. Original station mark found/not found. Description of mark: Original beacon found/not found. Description of beacon: Height Top of Vanes to Top Mark Height of mark above rock/conc below above G.L. Diameter of Vanes Height of Calm Original Beacon has/has not been destroyed by me.		

STATION **SUBLIME R/T (P) 4209**

Owner's Name:
 Address:
 Phone:
 Current Occupant:
 Address:
 Phone:

Access Report of /18 was found suitable/unsuitable.

4209 SUBLIME GS MARCH 2004

- 0.0 At Panorama look out / restaurant, 1.1km north of Bulli Tops road house, Head north along Princes HWY towards Sydney.
- 1.5 Turn right Sublime Point look out.
- 1.8 Park in car parking area (trig is at look out.)

INSPECTED BY: **G. L FORD** DATE: **26/3/01**

Date	Record of Station