


Department of Lands  
 STATION **GREAT SUGARLOAF (PT-S. (4213))**  
 Co: Northumberland | Ph: Teralba  
 Map Sheet: **NEWCASTLE**  
 Inspected by: **L. M Hayes**  
 Authority: Dept of Lands  
 No: **9232**  
 Date: **August 1976**  
 Field Book: **FDP 742**

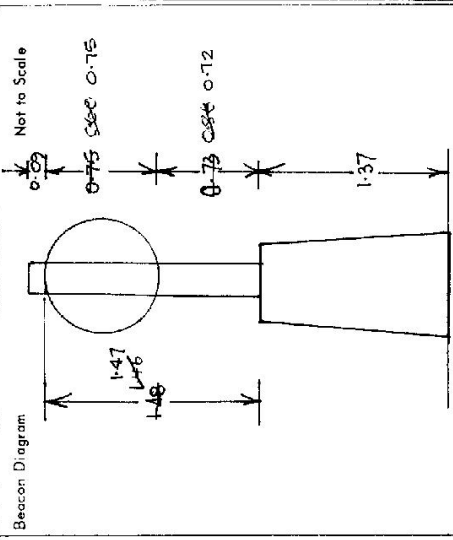

Date	Record of Station
27.2.20	RE-INSPECTED BY DIMAR FB 6603-253 PG 0093
25.6.84	NEW MAST/VAPE DIMENSIONS ABOVE STATIONS WAS 6650 CONDITION

Integral Survey of N.S.W  
**RECONNAISSANCE and MAINTENANCE REPORT**

This Trig. Station has been:-  
 Note: Cross out word or words which do not apply

1. Completely cleared to permit 360° vision to surrounding Trigs.
2. Cleared by lanes bearing ..... from Trig. Mast
3. Trig. Mast & Vanes have been painted white & black respectively.
4. The Trig. was unpiled/~~unpiled~~ dimensions now being:

Description of mark: **Concrete Pillar** should be explicit, e.g. Steel plug, Brass plug, Bolt, Concrete Pillar  
 Height of mark: **1.37** m above ~~base~~ **1.57** m above **G.L.**  
 Height of Top Vanes to ~~base~~ **Top pillar plate** **1.48** m Diameter of Vanes (vertical) **0.68** m.  
 Height of Cairn: ..... m. Diameter of Cairn ..... m.

- Length of Mast: ..... m. (approximate if not unpiled)
5. A. **SSM** set in ~~stone~~ rock has been placed/fd **3.217** m. bearing **305**°M from Trig. ~~stone~~ pillar
  6. A **Trig. Plug** set in conc/~~stone~~ has been placed/fd **6.752** m. bearing **315**°M from Trig. ~~stone~~ pillar
  7. A ..... set in conc/soil has been placed/fd ..... m. bearing .....°M from Trig. Mast/pillar
  8. A ..... set in conc/rock has been placed/fd ..... m. bearing .....°M from Trig. Mast/pillar
  9. Connection **Trig. Plug** to **SSM** : **3.625** m. bearing **140**°M

10. Connection: ..... to ..... m. bearing .....°M
11. Connection: ..... to ..... m. bearing .....°M
12. Connection: ..... to ..... m. bearing .....°M
13. Diff. Ht. **SSM** is **1.71** m. ~~above~~ **below** **pillar plate** ✓
14. Diff. Ht. **Trig. Plug** is **1.92** m. ~~above~~ **below** **pillar plate** ✓
15. Diff. Ht. .... is ..... m. ~~above~~ **below** .....
16. Diff. Ht. .... is ..... m. ~~above~~ **below** .....

Prepared by: **L. M Hayes** Checked: **[Signature]**

GREAT STATION Sugar TS 4213



Current Occupant:

Address:

Owners Name:

Address:

Access August 1976

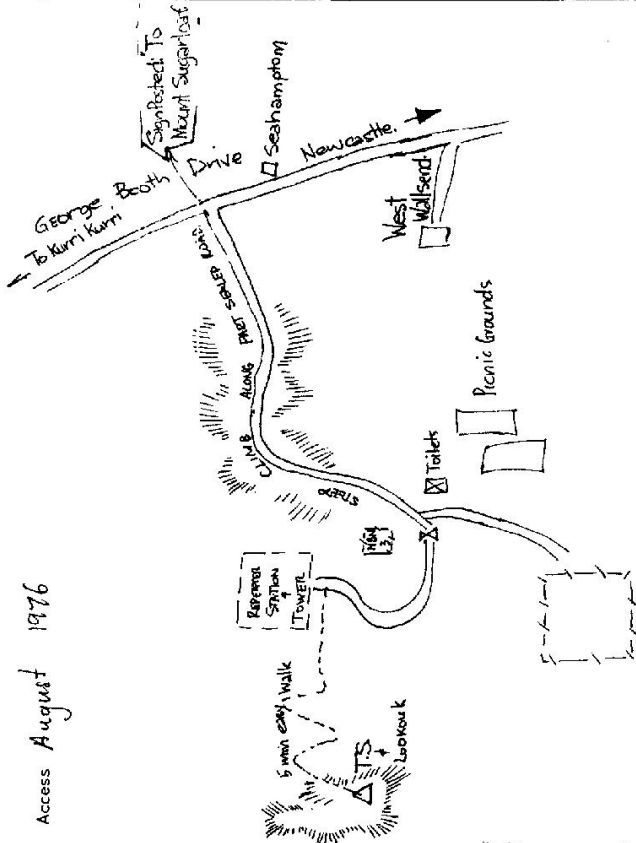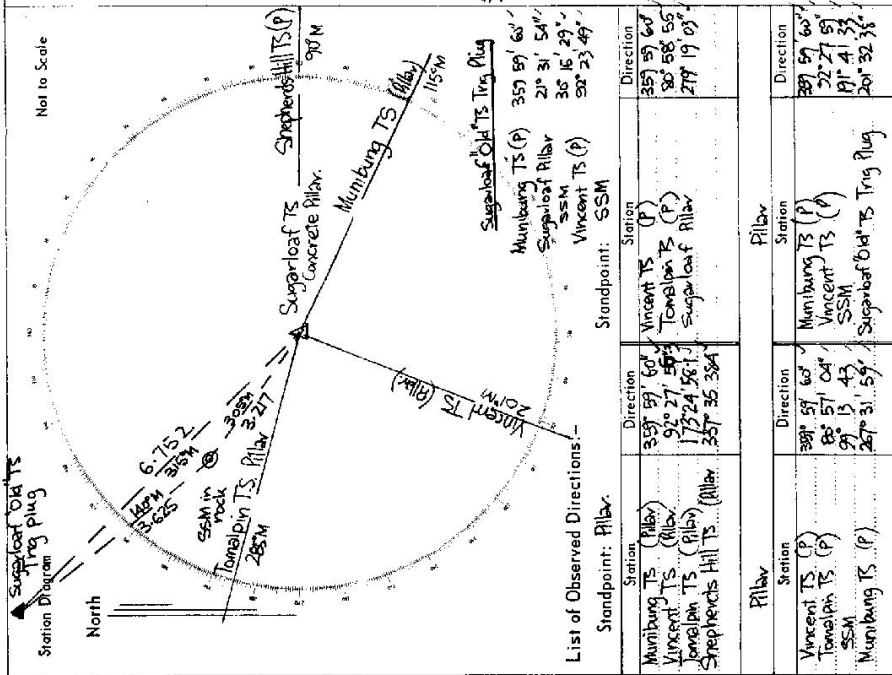

D. West, Government Printer, New South Wales - 1976

Card 1 of 3 Cards.

GEODETTIC SURVEY OF N.S.W.

CENTRAL MAPPING AUTHORITY

GEODETTIC STATION RECONNAISSANCE and MAINTENANCE REPORT

Description:

Note: Cross out word or words which do not apply

- Cleared by lanes bearing  $360^\circ$  except for small bushes adjacent to pillar: from Trig. Mast
- Mast & Vanes have been painted white & black respectively.
- The ~~steel~~ pillar was unpiled/~~set~~ ~~replaced~~/~~constructed~~ on  $25.11.1982$ , dimensions now being:   
 *Steel Pillar*  
 Description of mark ~~should~~ be explicit, e.g., S/Steel Pillar Plate, Steel plug, Brass plug, Bolt, G.I. Pipe  
 Height of mark  $1.36$  m. above rock/concrete; Mark is  $1.56$  m. above G.L.  
 Height of Top Vanes to Top Mark/Pillar plate  $1.245$  m. Diameter of Vanes (vertical)  $0.750$  m.  
 Height of Cairn  $0.245$  m. Diameter of Cairn  $0.245$  m. Name Plate found ~~not found~~ placed.
- A.  $S.S.M.$  set in ~~conc~~/rock has been ~~placed~~/found, bearing  $311^\circ 00'$  M from ~~steel~~ ~~plug~~ Pillar
- A. *Old Trig. Plug* set in ~~conc~~/rock has been ~~placed~~/found, bearing  $318^\circ 00'$  M from ~~Mast~~ ~~Plug~~ Pillar
- A. *Drill hole w. wing* set in ~~conc~~/rock has been ~~placed~~/found, bearing  $337^\circ 00'$  M from ~~Mast~~ ~~Plug~~ Pillar
- A. *G.I. Pipe* set in ~~conc~~/rock has been ~~placed~~/found, bearing  $20^\circ 00'$  M from ~~Mast~~ ~~Plug~~ Pillar
- Action required: ~~None~~

STANDPOINT:


Mark	Direction	Horiz. Distance	Height Difference
<i>Tomakin (P)</i>	$0^\circ 00' 00''$		above standpt
<i>S.S.M. in rock fl</i>	$18^\circ 11' 18''$	$3.217$	above standpt
<i>Old Trig. Plug fl</i>	$28^\circ 08' 21''$	$6.753$	above standpt
<i>Drill hole w wing fl</i>	$49^\circ 59' 26''$	$8.282$	above standpt
<i>Centre NBN 3</i>	$91^\circ 35' 00''$	$133.043$	above standpt
<i>TV Tower (Top)</i>		by calc.	above standpt

STANDPOINT:

Mark	Direction	Horiz. Distance	Height Difference
<i>Electricity Commission Radio Receiver Tower (Top)</i>	$97^\circ 27' 00''$	$59.303$	above standpt
<i>G.I. Pipe in conc fl</i>	$99^\circ 11' 28''$	$7.494$	above standpt
<i>Centre ABC 5</i>	$231^\circ 58' 26''$	$74.735$	above standpt
<i>TV Tower (Top)</i>	$279^\circ 02' 56''$	by calc.	above standpt
<i>VINCENT (P)</i>			above standpt
			below

Prepared by: *John Maylor* 21.12.82. Checked: *J. Manning* 18.01.83. Note on U.T.M. Card

STATION: *GREAT SUNG-AR-LIOAF (P)* No: *4213*  
 MAP SHEET SCALE 1:250 000  
 INSPECTED BY: *P. Maylor* DATE: *25.11.82.*  
 AUTHORITY: *C.M.A.* FIELD BOOK: *1931.*

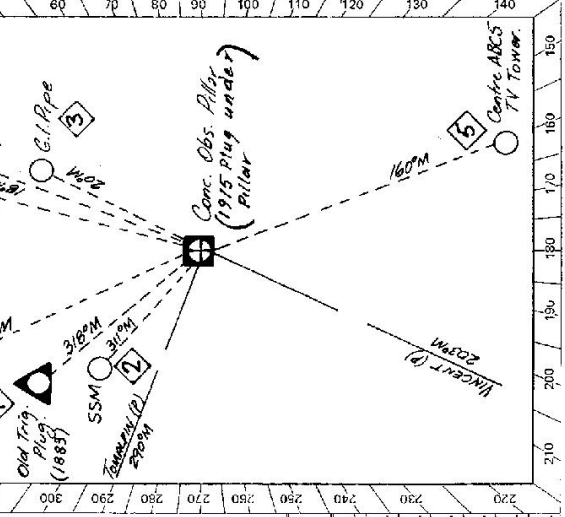

Not to Scale  
 Station Diagram  
 North  
 Checked

GS 24


STATION **GREAT SUGARLOAF (P) IS 4213**

Owner's Name: .....  
 Address: .....  
 Phone: .....  
 Current Occupant: .....  
 Address: .....  
 Phone: .....  
**ABC 5**


**ACCESS**

Access Report of 25/11/1982 was found suitable/unsuitable.

**PROFILES OF TOWERS**

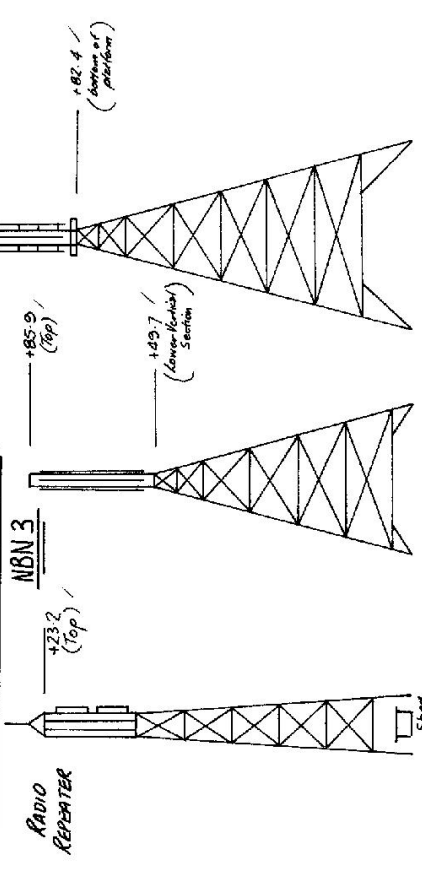

\* Heights shown are in metres above Pillar Plate.

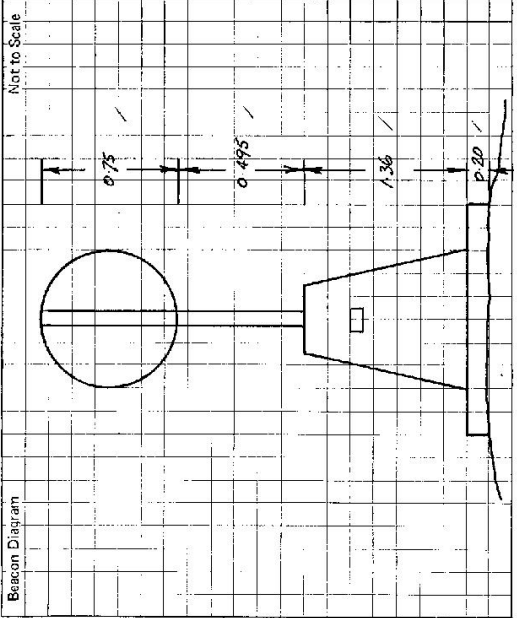


This station to be completed by officer constructing pillar.

Original station mark found/~~not found~~.  
 Description of mark: **Conc. Obs. Pillar**  
 Original beacon found/~~not found~~.  
 Description of Beacon: **PVC Mast & Vanes**  
 Height Top of Vanes to Top Mark: **1.480** m. /  
 Height of mark: ..... m. above G.L.,  
 below rock/conc ..... m. below G.L.  
 Diameter of Vanes: **0.60** m. / Height of Cairn ..... m.  
 Original Beacon has/~~has not~~ been destroyed by me.

Date	Record of Station

Card 2 of 3 Cards  
 STATION: **GREAT SUGARLOAF (P)** No.: **4213**  
 MAP SHEET  
 SCALE 1:250 000  
 INSPECTED BY: **P. Naylor** DATE: **25.11.82**  
 AUTHORITY: **C.M.A.** FIELD BOOK: **1931.**

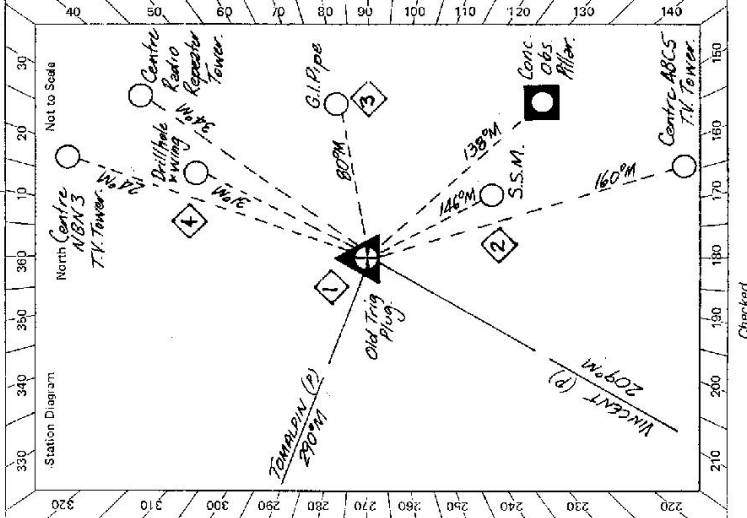

CENTRAL MAPPING AUTHORITY  
 GEODETIC SURVEY OF N.S.W.  
 GEODETIC STATION RECONNAISSANCE and MAINTENANCE REPORT


Description:  
 Note: Cross out word or words which do not apply  
 Cleared by lanes bearing..... from Trig. Mast  
 1. Mast & Vanes have been painted white & black respectively.  
 2. The station/pillar was unpiled/not unpiled/constructed on.....  
 3. Description of mark..... should be explicit, e.g., S/Steel Pillar Plate, Steel plug, Brass plug, Bolt, G.I. Pipe  
 Height of mark..... m. above rock/concrete; Mark is..... m. above G.L.  
 Height of Top Vanes to Top Mark/Pillar plate..... m. Diameter of Vanes (vertical)..... m.  
 Height of Cairn..... m. Diameter of Cairn..... m. Name Plate found/not found/placed.  
 Length of Mast..... m. (approximate if not unpiled)  
 4. A..... set in conc/rock has been placed/found, bearing..... °M from Mast/Plug/Pillar  
 5. A..... set in conc/rock has been placed/found, bearing..... °M from Mast/Plug/Pillar  
 6. A..... set in conc/rock has been placed/found, bearing..... °M from Mast/Plug/Pillar  
 7. A..... set in conc/rock has been placed/found, bearing..... °M from Mast/Plug/Pillar  
 8. Action required.....

STANDPOINT:	Old Trig. Plug			Old Trig. Plug				
	Mark	Direction	Horiz. Distance	Height Difference	Mark	Direction	Horiz. Distance	Height Difference
Tomarlin (P)	0° 00' 00"			above standpt.	Conc. Obs Pillar	209° 01' 52"	6.752	1.919
Centre NBN3	94° 15' 29"			above standpt.	S.S.M. in rock fl.	216° 53' 26"	3.626	10.212
TV Tower				below	Centre ABCS	230° 01' 29"		
Drillhole & wiring for Radio Repeater Tower	101° 18' 12"		3.226	0.233	TV Tower			
Electricity Commission Tower				below	Vincent (P)	278° 59' 42"		
G.I. Pipe in conc. fl.	149° 33' 58"		8.310	10.303				

Prepared by: *Paul Naylor* 2.12.82 Checked: *J. Manning* 10 Dec 82  
 Note on U.T.M. Card  
 Checked



Card 3 of 3 Cards.  
STATION: GREAT SUGARLOAF (P) No.: 4213  
MAP SHEET SCALE 1:250 000  
INSPECTED BY: P. Maylor  
AUTHORITY: C. M. A.  
DATE: 25.11.82.  
FIELD BOOK: 1931.

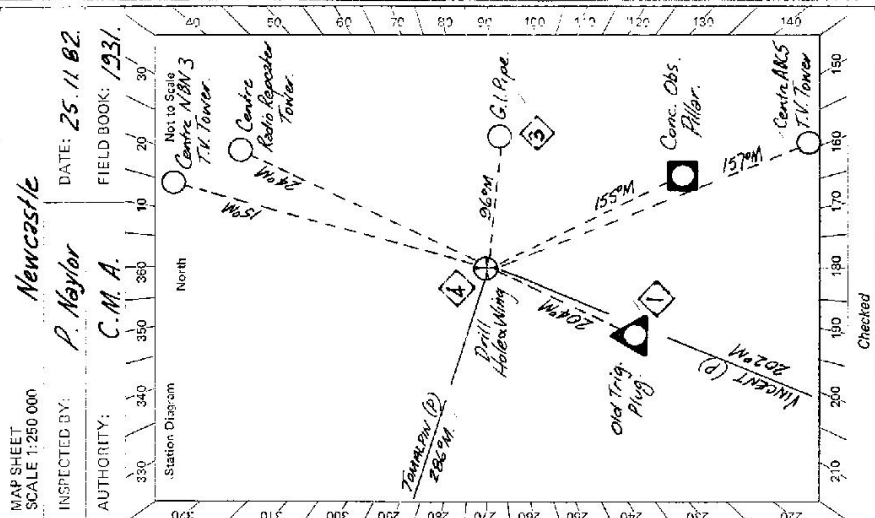

CENTRAL MAPPING AUTHORITY  
GEODETTIC SURVEY OF N.S.W.  
GEODETTIC STATION RECONNAISSANCE and MAINTENANCE REPORT

Description:  
1. Cleared by lanes bearing..... Note: Cross out word or words which do not apply  
2. Mast & Vanes have been painted white & black respectively.  
3. The station/pillar was unpiled/not unpiled/constructed on..... from Trig. Mast

Description of mark..... should be explicit, e.g., S/Steel Pillar Plate, Steel plug, Brass plug, Bolt, G.I. Pipe  
Height of mark..... m. above rock/concrete; Mark is..... m. above G.L.  
Height of Top Vanes to Top Mark/Pillar plate..... m. Diameter of Vanes (vertical)..... m.  
Height of Cairn..... m. Diameter of Cairn..... m. Name Plate found/not found/placed.

Length of Mast..... m. (approximate if not unpiled)

4. A. *Drill hole in wing* set in conc/rock has been placed/removed, bearing  $24^\circ$  M from Mast/Plug/Pillar *Drill hole in wing found.*
5. A..... set in conc/rock has been placed/removed, bearing..... M from Mast/Plug/Pillar
6. A..... set in conc/rock has been placed/removed, bearing..... M from Mast/Plug/Pillar
7. A..... set in conc/rock has been placed/removed, bearing..... M from Mast/Plug/Pillar

NOTE:  
Action required: *Drill hole in wing placed in roof of shed under Radio Reparat. Tower.*

STANDPOINT:		STANDPOINT:		STANDPOINT:			
Mark	Direction	Horiz. Distance	Height Difference	Mark	Direction	Horiz. Distance	Height Difference
Tower (P)	$0^\circ 00' 00''$		above standpt.	Centre Obs. R/A	$230^\circ 02' 04''$	8.280	1.692 above standpt.
Centre NBN 3	$94^\circ 06' 03''$		above standpt.	Centre ABC 5	$231^\circ 46' 30''$		above standpt.
T.V. Tower			above standpt.	T.V. Tower			above standpt.
Electricity Commission Radio Reparat. Tower	$103^\circ 57' 52''$		above standpt.	Old Trig. Plug	$201^\circ 22' 03''$	3.224	0.229 above standpt.
Drill hole in wing old.	$103^\circ 48' 30''$	53.919	24.44 above standpt.	VINCENT (P)	$279^\circ 00' 58''$		above standpt.
G.I. Pipe in conc. A.	$178^\circ 54' 16''$	6.616	10.533 above standpt.				above standpt.

Prepared by: P. Maylor 2.12.82. Checked: J. Manning 9.10.82. Noted on U.T.M. Card



GS 24

STATION **GREAT SUGARLOAF (P)** TS 4213

Owner's Name: .....  
 Address: .....  
 Phone: .....  
 Current Occupant: .....  
 Address: .....  
 Phone: .....

ACCESS  
 Access Report of 25.11.1982 was found suitable/unsuitable.

**CONNECTION TO RADIO REPEATER TOWER & M.B.N. 3.**

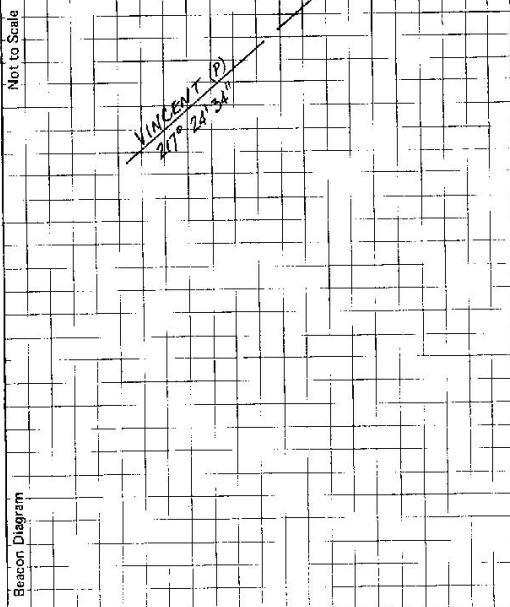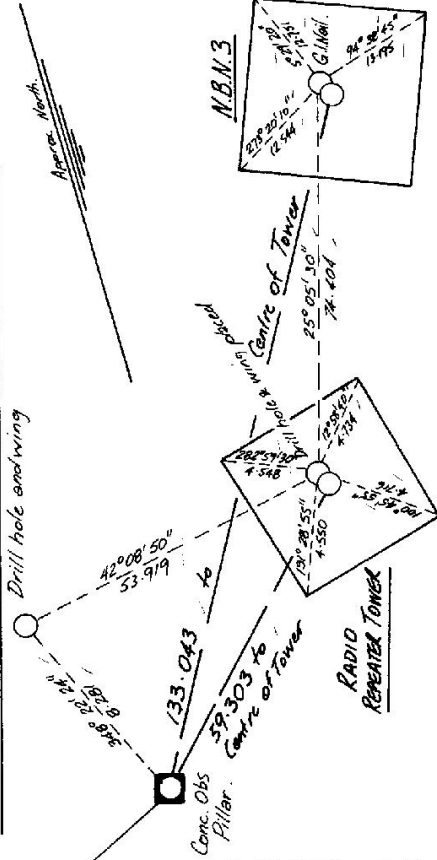

This section to be completed by officer constructing pillar.

Original station mark found/not found.

Description of mark: .....

Original beacon found/not found.

Description of beacon: .....

Height Top of Vanes to Top Mark: .....m.

Height of mark: .....m. above G.L. below

Diameter of Vanes: .....m.

Original Beacon has/has not been destroyed by me.

Date

Record of Station



CENTRAL MAPPING AUTHORITY

GEODETTIC SURVEY OF N.S.W.

GEODETTIC STATION RECONNAISSANCE and MAINTENANCE REPORT

Description:

1. Cleared by lanes bearing  $360^{\circ}$   $\pm$   $2.13^{\circ}$  M. Note: Cross out word or words which do not apply
2. Lower Black Vision  $13^{\circ} 16' 18''$   $\pm$   $23^{\circ} 14' 18''$  from Trig. Mast  
Mast & Vanes have been painted white & black respectively,  $163^{\circ} 14' 24''$   $\pm$   $333^{\circ} 14' 24''$
3. The ~~station~~ pillar was ~~replaced~~ on  $22^{\circ} 5'$   $\pm$   $19.8^{\circ}$  dimensions now being:  
Description of mark: ~~Steel Plate~~ should be explicit, e.g., S/Steel Pillar Plate, Steel plug, Brass plug, Bolt, G.I. Pipe  
Height of mark:  $1.60$  m. above below rock/concrete; Mark is  $1.55$  m. above below G.L.
- Height of Top Vanes to Top Mark/Pillar plate  $1.47$  m. Diameter of Vanes (vertical)  $7.5$  m.
- Height of Cairn  $1.55$  m. Diameter of Cairn  $1.47$  m. Name Plate found/ ~~not found~~ placed, Central Mapping Authority
- Length of Mast  $1.55$  m. (approximate if not specified) Geodetic Station  $\pm$  SUGARLOAF
4. A.  $1.55$  set in conc/rock has been placed/found, bearing  $198^{\circ}$  M from Mast/Plug/Pillar
5. A.  $1.55$  set in conc/rock has been placed/found, bearing  $198^{\circ}$  M from Mast/Plug/Pillar
6. A.  $1.55$  set in conc/rock has been placed/found, bearing  $198^{\circ}$  M from Mast/Plug/Pillar
7. A.  $1.55$  set in conc/rock has been placed/found, bearing  $198^{\circ}$  M from Mast/Plug/Pillar
8. Action required: .....

STANDPOINT:

Mark	Direction	Horiz. Distance	Height Difference	Mark	Direction	Horiz. Distance	Height Difference
			above standpt.				above standpt.
			below				below
			above standpt.				above standpt.
			below				below
Prepared by: D. K. G. V. A.

Checked: *[Signature]*

Noted on U.T.M. Card *[Signature]*

STATION: SUGARLOAF CON. PILLAR No.: 4213

MAP SHEETS: SCALE 1:250 000

INSPECTED BY: D. J. KAIN DATE: 28.5.1983

AUTHORITY: C.M.A. FIELD BOOK: C.433

Station Diagram

North

Not to Scale

STATION WAS VISITED FOR PURPOSE OF MAINTENANCE AND INSPECTION ONLY.

+

Checked *[Signature]*

GS 24

STATION SUGARLOAF CONCRETE PILLAR TS 4213

Owner's Name: .....  
 Address: .....  
 Phone: .....

Current Occupant: .....  
 Address: .....  
 Phone: .....

ACCESS

Access Report of 28/5/1986 was found suitable/unsuitable.


FIGURE

- / 0.00 AT MINIMI POOL OFFICE TRAVEL SOUTH ALONG "CAMERON PARK DRIVE."
  - / 3.92 THEN RIGHT AT "T JUNCTION" ONTO "GEORGE BOOTH DRIVE" TOWARD KURRI KURRI.
  - / 4.01 PASS "WEST WALLS" END TURN OFF ON L.H.S.
  - / 5.07 PASS THROUGH VILLAGE OF SEHAMPTON
  - / 6.48 TURN LEFT AT SIGNPOST "MOUNT SUGARLOAF."
  - / 9.70 PASS MT. VINCENT TURN-OFF ON L.H.S.
  - / 10.10 LOCKED DOUBLE IRON GATES NEXT TO N.B.N. TRANSMITTER-C.M.A. PADLOCK FITTED.
  - / 10.20 LEAVE VEHICLE, 5 MINUTE EASY WALK TO STATION ALONG AND UP FORMED WALKING TRAIL.
- ALL WEATHER ACCESS TO CONVENTIONAL TYPE VEHICLE.

Record of Station

Date

SI 2733-2 D. West Government Printer

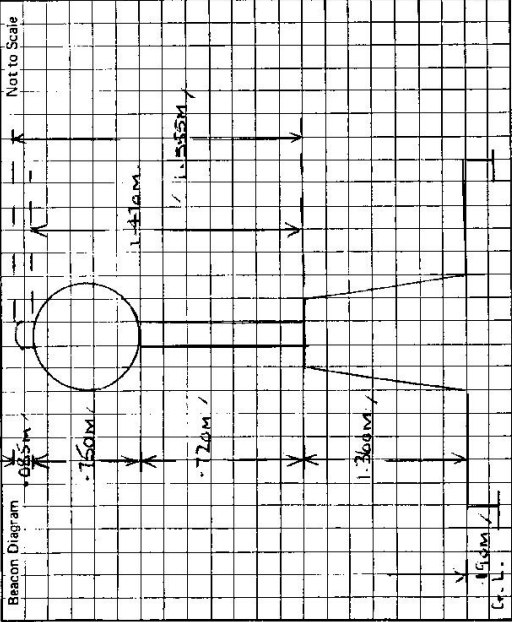

This section to be completed by officer constructing pillar.

Original station mark found/not found.

Description of mark: .....

Original beacon found/not found.

Description of beacon: .....

Height Top of Vanes to Top Mark.....m.

Height of mark.....m. above G.L. below

Diameter of Vanes .....m. Height of Cairn .....m.

Original Beacon has/has not been destroyed by me.


MEMORANDUM

Survey Control Bench

NEWCASTLE

~~re TS SUGARLOAF (P)~~  
GREAT SUGARLOAF 4213

New mast and Vanes erected  
25/6/84  
Details below.

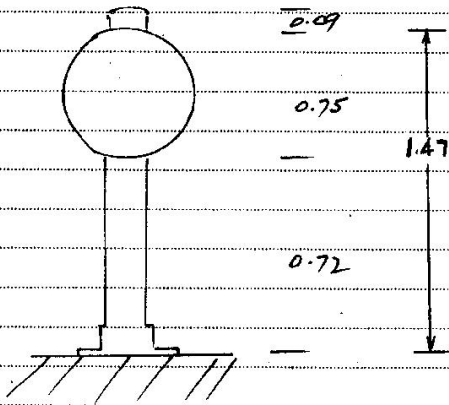

*[Signature]*  
25/6/84

~~to [unclear] Sab.~~  
P. Naylor - CMA  
Rec'd 14/2/84 A.