

CENTRAL MAPPING AUTHORITY
Department of Lands

Trigonometrical Survey of N.S.W.

RECONNAISSANCE and MAINTENANCE REPORT

This Trig. Station has been:-

Note: Cross out word or words which do not apply

1. Completely cleared to permit 360° vision to surrounding Trigs. ✓
2. Cleared by lines bearing from Trig. Mast
3. Trig. Mast & Vanes have been painted white & black respectively.
4. The Trig. was ~~unpiled~~/not unpiled, dimensions now being:

Description of mark ~~NOT UNPILED~~ should be explicit, e.g. Steel plug, Brass plug, Bolt, G.I. Pipe
 Height of mark m above rock/concrete m below G.L.
 Height of Top Vanes to Top Mark m. Diameter of Vanes (vertical) 0.61 m.
 Height of Cairn 1.2 m. Diameter of Cairn 1.2 m.
 Length of Mast 3.6 m. (approximate if not unpiled)

5. A set in conc/rock has been placed m. bearing°M from Trig. Mast
6. A set in conc/soil has been placed m. bearing°M from Trig. Mast
7. A set in conc/soil has been placed m. bearing°M from Trig. Mast
8. A set in conc/rock has been placed m. bearing°M from Trig. Mast

9. Connection: to m. bearing°M
10. Connection: to m. bearing°M
11. Connection: to m. bearing°M
12. Connection: to m. bearing°M
13. Diff. Ht. is m. above below
14. Diff. Ht. is m. above below
15. Diff. Ht. is m. above below
16. Diff. Ht. is m. above below


Prepared by: W. J. G. G. G. 30/5/76 Checked: _____

Noted on U.T.M. Card K 23 8-76 Checked

STATION SWALLOWTAIL TS 4237

Co: ARGYLE
 Map Sheet: TARALGA
 Inspected by: A PATTERSON
 Authority: C.M.A.
 No: 8829
 Date: 27th MAY 1976
 Field Book:
 Not to Scale

Beacon Diagram

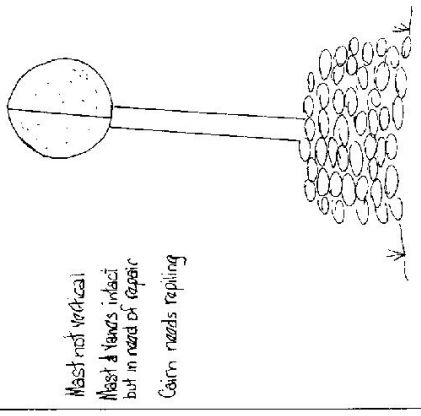

Date _____ Record of Station _____

