

CENTRAL MAPPING AUTHORITY

GEODETIC SURVEY OF M.S.W


GEODETIC STATION RECONNAISSANCE and MAINTENANCE REPORT

STATION: SMA 0695 No.: 426

MAPSHEET SCALE 1:250 000 BEGA

INSPECTED BY: G. KEEP DATE: 25/2/80

AUTHORITY: FIELD BOOK:

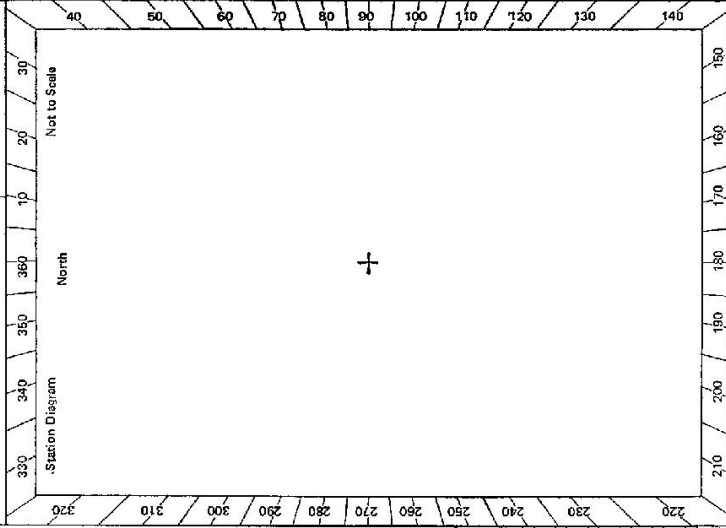


- Description:
- Cleared by lanes bearing..... Note: Cross out word or words which do not apply
  - Mast & Vanes have been painted white & black respectively..... from Trig. Mast
  - The station/pillar was unpiled/not unpiled/constructed on..... 19....., dimensions now being: Description of mark..... should be explicit, e.g., S/Steel Pillar Plate, Steel plug, Brass plug, Bolt, G.I. Pipe  
 Height of mark.....<sup>above</sup> m, <sup>below</sup> m, concrete; Mark is.....<sup>above</sup> m, <sup>below</sup> G.L.  
 Height of Top Vanes to Top Mark/Pillar plate..... m. Diameter of Vanes (vertical)..... m.  
 Height of Cairn..... m. Diameter of Cairn..... m. Name Plate found/not found/placed.  
 Length of Mast..... m. (approximate if not unpiled)
  - A..... set in conc/rock has been placed/found, bearing..... °M from Mast/Plug/Pillar
  - A..... set in conc/rock has been placed/found, bearing..... °M from Mast/Plug/Pillar
  - A..... set in conc/rock has been placed/found, bearing..... °M from Mast/Plug/Pillar
  - A..... set in conc/rock has been placed/found, bearing..... °M from Mast/Plug/Pillar
  - Action required: *Needs painting black and white*

STANDPOINT:				STANDPOINT:			
Mark	Direction	Horiz. Distance	Height Difference	Mark	Direction	Horiz. Distance	Height Difference
			above standpt.				above standpt.
			below				below
			above standpt.				above standpt.
			below				below
Prepared by: G. Keep 12/6/80 Checked: Noted on U.T.M. Card

CS
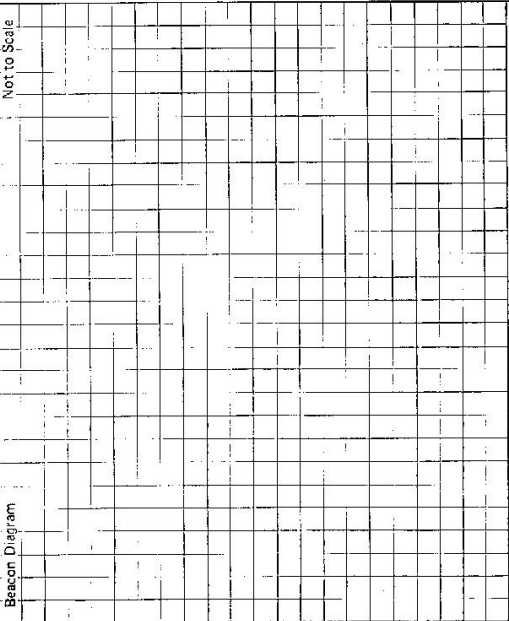
<p>21.2753-2 D. West, Government Printer</p>	<p>STATION <b>SMA 0695</b> TS <b>426</b></p>	<p>Owner's Name: .....                  Address: .....                  Phone: .....</p> <p style="text-align: center;"><u>ACCESS</u></p> <p>Current Occupant: .....                  Address: .....                  Phone: .....</p> <p>Access Report of ...../1B..... was found suitable/unsuitable.  <i>Not suitable for Geodetic station.</i></p>
<p>Beacon Diagram</p>  <p style="text-align: right;">Not to Scale</p>	<p>This section to be completed by officer constructing pillar.</p> <p>Original station mark found/not found.</p> <p>Description of mark: .....</p> <p>Original beacon found/not found.</p> <p>Description of beacon: .....</p> <p>Height Top of Vanes to Top Mark .....m.                  above rock/conc. ....m. below G.L.</p> <p>Height of mark .....m. below</p> <p>Diameter of Vanes .....m. Height of Cairn .....m.</p> <p>Original Beacon has/has not been destroyed by me.</p>	
	<p>Date</p>	<p>Record of Station</p>