

CENTRAL MAPPING AUTHORITY

GEODETTIC SURVEY OF N.S.W.

GEODETTIC STATION RECONNAISSANCE and MAINTENANCE REPORT

STATION: TAMBAROCORA No.: 4269

MAP SHEET SCALE 1:250 000 DUBBO

INSPECTED BY: R. ELLIS DATE: 20-7-81

AUTHORITY: C.M.A. FIELD BOOK: 01917

Description: *Note: Cross out word or words which do not apply*


1. Cleared by lanes bearing..... ~~COMPLETELY OVERGROWN~~..... from Trig. Mast
2. Mast & Vanes have been painted white & black respectively
3. The station, pillar was ~~erected~~ not unplied/constructed on..... 20'-7"-19.81..... dimensions now being: Description of mark..... should be explicit, e.g., S/Steel Pillar Plate, Steel plug, Brass plug, Bolt, G.I. Pipe
Height of mark..... m. above rock/concrete; Mark is..... m. above G.L.
- Height of Top Vanes to Top Mark/Pillar plate..... m. Diameter of Vanes (vertical)..... m.
- Height of Cairn..... 2.5..... m. Diameter of Cairn..... 2.5..... m. Name Plate found/not found/placed.
- Length of Mast..... m. (approximate if not unplied)
4. A..... set in conc/rock has been placed/found, bearing..... °M from Mast/Plug/Pillar
5. A..... set in conc/rock has been placed/found, bearing..... °M from Mast/Plug/Pillar
6. A..... set in conc/rock has been placed/found, bearing..... °M from Mast/Plug/Pillar
7. A..... set in conc/rock has been placed/found, bearing..... °M from Mast/Plug/Pillar

8. Action required: **TOTAL WEEK-CLEARING & PILLAR CONSTRUCTION IS REQUIRED**

STANDPOINT:				STANDPOINT:			
Mark	Direction	Horiz. Distance	Height Difference	Mark	Direction	Horiz. Distance	Height Difference
			above standpt.				above standpt.
			below				below
			above standpt.				above standpt.
			below				below
Prepared by: *Ellis* 22/7/81 Checked: *Ellis* 22/7/81

Noted on U.T.M. Card

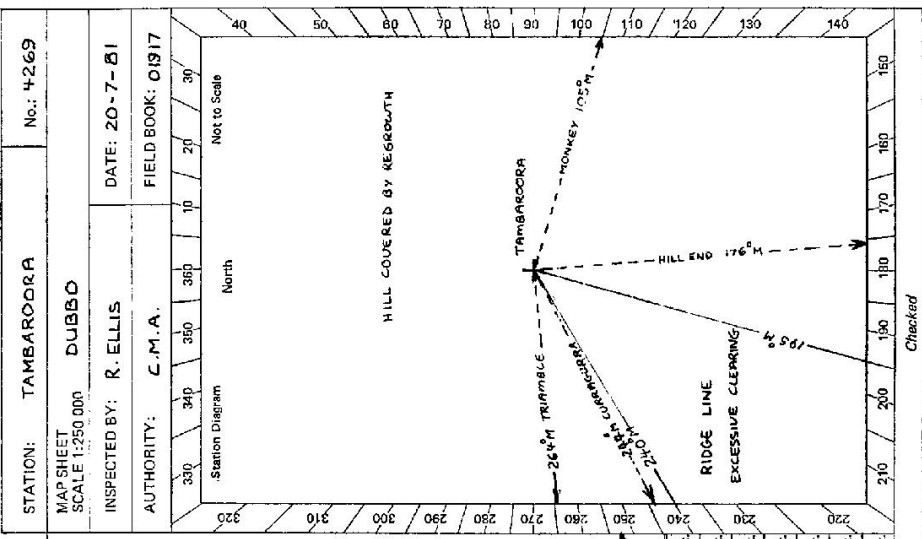

Checked

812733-1

STATION **TAMBAROORA TS 4269**

Owner's Name: **TR 40095** Current Occupant:

Address: Address:

Phone: Phone:

ACCESS

Access Report of **20/7/19** was found suitable/unsuitable.

Km	Features
0.0	P.O. HILLEN-HEAD NORTH PAST POLICE STN.
0.5	PASS 'ROYAL HOTEL' AND GENERAL STORE.
0.8	PASS 'LEE LANE' ON LEFT.
0.9	TAKE LEFT FORK TO 'MUDGE 73'
1.6	GRAVEL ROAD.
3.4	CROSS CREEK
4.8	PASS TRACK ON LEFT
6.1	TAKE LEFT FORK ~ SIGN 'DIXONS LONG POINT ROAD - ULLAMALLA'
7.2	PASS TRACK ON LEFT.
8.1	TURN RIGHT
8.7	TURN LEFT
8.9	IRON GATE
9.1	TAKE RIGHT FORK ~ FOLLOW TRACK
9.9	IRON GATE ~ FOLLOW FAINT TRACK.
10.9	IRON GATE ~ VEER SLOWLY RIGHT AND UP HILL. AFTER GATE
11.0	NO DEFINITE TRACK
	'TAMBAROORA' TRIG

Beacon Diagram Not to Scale

*MIST & GAMES IN ROCK CONVICTION
ROCK CAIRN EXTRACT*

This section to be completed by officer constructing pillar.

Original station mark found/not found:

Description of mark:

Original beacon found/not found:

Description of beacon:

Height Top of Vanes to Top Mark:m.

Height of mark:m. above G.L. below

Diameter of Vanes:m. Height of Cairn:m.

Original Beacon has/has not been destroyed by me:

Date	Record of Station