

CENTRAL MAPPING AUTHORITY

GEODETIC SURVEY OF M.S.W.

GEODETIC STATION RECONNAISSANCE and MAINTENANCE REPORT

Description:

1. ~~Cleared by~~ *Shocking Mon. of 163 m. to 225 m. to 233 m. 259 m.* from Trig. Mast
Note: Cross out word or words which do not apply
2. Mast & Vanes have been painted white & black respectively. ✓
3. The station/~~pillar~~ was ~~emptied~~/~~not unpiled~~/~~constructed~~ on *19.10.19.78*, dimensions now being:

Description of mark.....should be explicit, e.g., S/Steel Pillar Plate, Steel plug, Brass plug, Bolt, G.I. Pipe

Height of mark.....m. ^{above}/_{below} rock/concrete; Mark is.....m. ^{above}/_{below} G.L.

Height of Top Vanes to Top Mark/Pillar plate.....m. Diameter of Vanes (vertical).....m.

Height of Cairn.....m. Diameter of Cairn.....m. Name Plate ~~found~~/~~not found~~/~~placed~~.....

Length of Mast.....m. (approximate if not unpiled)

4. A.....*S.S.P* set in ~~conc~~/~~rock~~ has been ~~placed~~/~~found~~, bearing.....°M from Mast/Plug/Pillar

5. A.....*G.I. Pipe* set in ~~conc~~/~~rock~~ has been ~~placed~~/~~found~~, bearing.....°M from Mast/Plug/Pillar

6. A..... set in ~~conc~~/~~rock~~ has been ~~placed~~/~~found~~, bearing.....°M from Mast/Plug/Pillar

7. A..... set in ~~conc~~/~~rock~~ has been ~~placed~~/~~found~~, bearing.....°M from Mast/Plug/Pillar

8. Action required:.....

STANDPOINT:

Mark	Direction	Horiz. Distance	Height Difference	Mark	Direction	Horiz. Distance	Height Difference
			above standpt.				above standpt.
			below standpt.				below standpt.
			above standpt.				above standpt.
			below standpt.				below standpt.
Prepared by: *[Signature]*

Checked: *[Signature]*

Noted on U.T.M. Card


ST 2733-1

STATION: *TARAGO G.S.* No.: *4283*

MAP SHEET SCALE 1:250 000
CANBERRA

INSPECTED BY: *M.L. Morrison* DATE: *19-10-78*

AUTHORITY: *C.M.A.* FIELD BOOK: *1710*

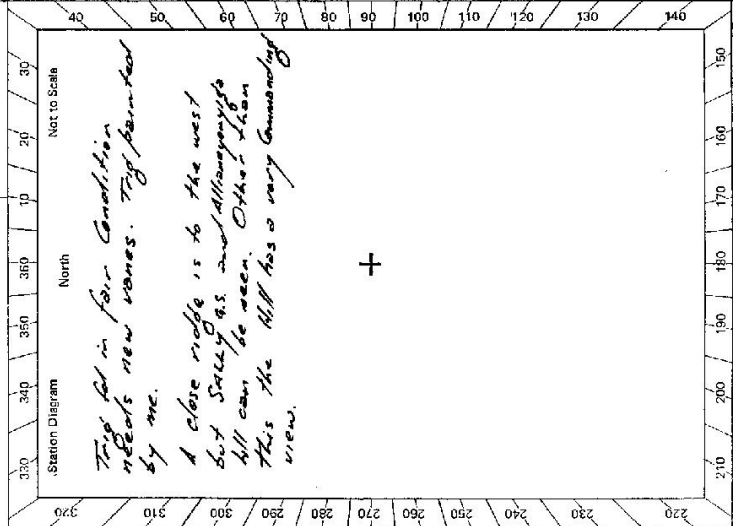

Checked

GEODETTIC SURVEY OF N.S.W.

CENTRAL MAPPING AUTHORITY

GEODETTIC STATION RECONNAISSANCE and MAINTENANCE REPORT

Description:

1. Cleared by-lanes bearing *all directions* from Trig. Mast

2. Mast & Vanes have been painted white & black respectively in cairn of rocks *signed*

3. The station/pillar was unpiled/not unpiled/constructed on *19* dimensions now being:

Description of mark *should be explicit, e.g., S/Steel Pillar Plate, Steel plug, Brass plug, Bolt, G.I. Pipe*

Height of mark *above/below rock/concrete* Mark is *above/below* G.L.

Height of Top Vanes to Top Mark/Pillar plate *m.* Diameter of Vanes (vertical) *m.*

Height of Cairn *m.* Diameter of Cairn *m.* Name Plate found/not found/placed.

Length of Mast *m.* (approximate if not unpiled)

4. A *set in conc/rock has been placed/found, bearing 0°M from Mast/Plug/Pillar*

5. A *set in conc/rock has been placed/found, bearing 0°M from Mast/Plug/Pillar*

6. A *set in conc/rock has been placed/found, bearing 0°M from Mast/Plug/Pillar*

7. A *set in conc/rock has been placed/found, bearing 0°M from Mast/Plug/Pillar*


8. Action required:

STATION: *Tarago* No.: *4283*

MAP SHEET SCALE 1:250 000 *Canberra*

INSPECTED BY: *P.K. Bamob* DATE: *20/4/19*

AUTHORITY: *C.M.A* FIELD BOOK:

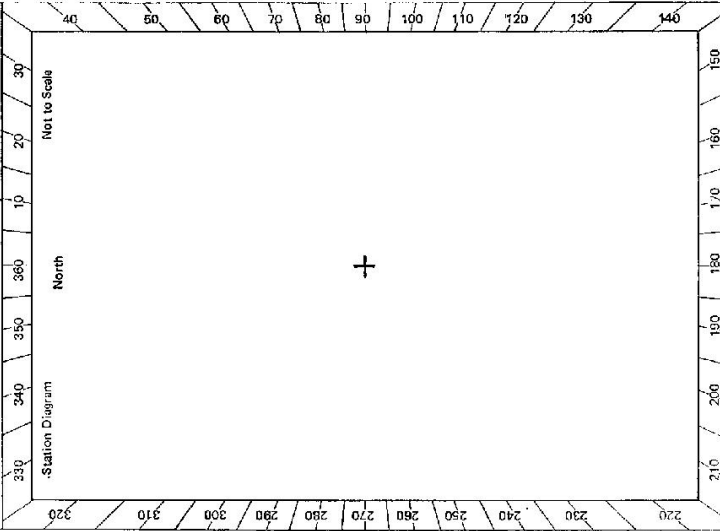


STANDPOINT:							
Mark	Direction	Horiz. Distance	Height Difference	Mark	Direction	Horiz. Distance	Height Difference
			above standpt.				above standpt.
			below standpt.				below standpt.
			above standpt.				above standpt.
			below standpt.				below standpt.
Prepared by: *Noted on U.T.M. Card*

Checked:

Checked:

St. 2733 - 2 D. West, Government Printer

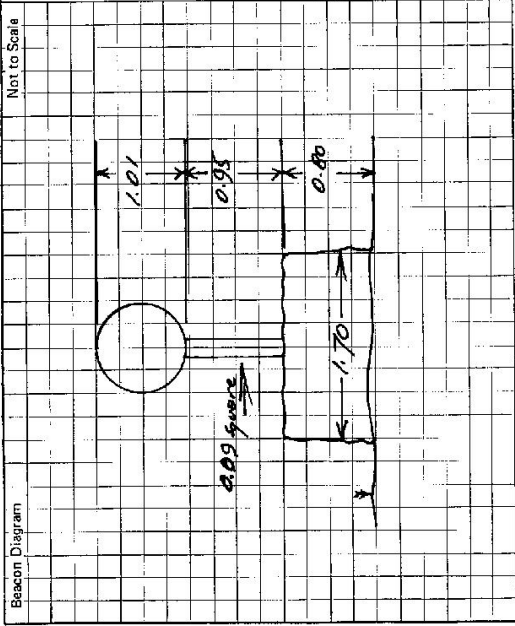

This section to be completed by officer constructing pillar.

Original station mark found/not found.

Description of mark:

Original beacon found/not found.

Description of beacon:

Height Top of Vanes to Top Mark.....m.

Height of mark.....m. above G.L. below

Diameter of Vanes.....m. Height of Cairn.....m.

Original Beacon has/has not been destroyed by me.

STATION **Taraso G.S. JS 4283**

Owner's Name: **SERGEANT P. LTD**

Current Occupant:

Address: **LAKE BURWELL**

Address:

Phone: **11503**

Phone:

ACCESS

Access Report of 19/10/18 was found suitable/unsuitable.

Key **Direction**

0.00 **Taraso Rd. head west towards Condens**

0.75 **Levee crossing near Blue Station**

0.90 **Turn right and head up driveway past**

1.25 **Catholic Church**

1.80 ***Locate gate. Go through and straight ahead**

1.90 **through second gate**

2.55 **Creek crossing turn right off main track towards**

2.65 **gate which can be seen from here**

3.55 **GATE**

Turn right off track at 0.1km before gate (near billboard hole)

creek crossing/cutting in bank near to bend in creek

near left and follow spur you are on.

TARASO G.S.

*** KEY OBTAINABLE AT I. G. BOYD CARRIER CONTRACTOR opp Taraso Rd.**

Date

Record of Station