


Department of Lands
 Integration by of N.S.W.
RECONNAISSANCE and MAINTENANCE REPORT
 STATION TAREE TS (4287)

This Trig. Station has been:-
 Note: Cross out word or words which do not apply

Co: Macquarie
 Map Sheet: Camden Haven South
 No: 9434
 Inspected by: P. R. Healdon
 Date: 8-9-17
 Authority: LANDS DEPT
 Field Book: TAREE 1/25
 Beacon Diagram
 Not to Scale

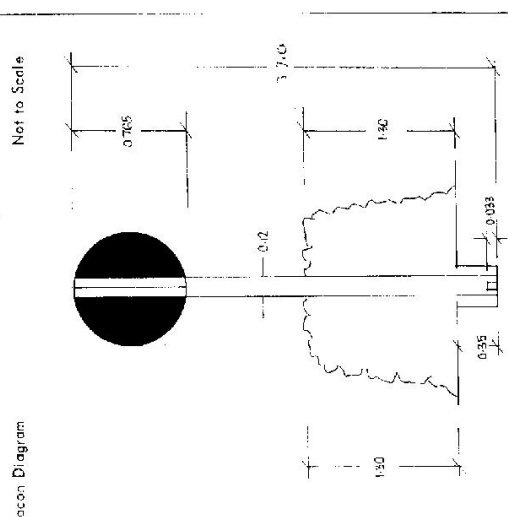

Date: _____ Record of Station
 8-9-77: Connections & observations Trig respiled

1. ~~Completely cleared to permit 360° vision to surrounding trig~~
2. Cleared by lances bearing $0^{\circ}-40'$, $168^{\circ}-19'$, $290^{\circ}-29'$ M. from Trig. Mast
3. Trig. Mast & Vanes have been painted white & black respectively.
4. The Trig. was unpiled/~~not supplied~~, dimensions now being:
 - Description of mark.... Brass Plug should be explicit, e.g. Steel plug, Brass plug, Bell, Concrete Pillar
 - Height of mark..... 0.35..... m ^{above} ~~below~~ ~~seek~~ concrete 0.3..... m ^{above} ~~below~~ G.L.
 - Height of Top Vanes to Top Mark/~~Top pillar plate~~..... 3.617. m Diameter of Vanes (vertical). 0.765. m.
 - Height of Cairn..... 1.3..... m. Diameter of Cairn. 1.85..... m.
 - Length of Mast..... 3.710..... m. (approximate if not unpiled)
5. A..... 59M..... set in conc/~~soil~~ has been placed/fd 3.610. m. bearing..... 48..... °M from Trig. Mast/~~pillar~~
6. A..... 61P..... set in conc/~~soil~~ has been placed/fd 3.443. m. bearing..... 379..... °M from Trig. Mast/~~pillar~~
7. A..... set in conc/~~soil~~ has been placed/fd m. bearing..... °M from Trig. Mast/~~pillar~~
8. A..... set in conc/~~rock~~ has been placed/fd m. bearing..... °M from Trig. Mast/~~pillar~~
9. Connection 59M to 61P..... 4.740 m. bearing 279..... °M
10. Connection..... to..... m. bearing..... °M
11. Connection..... to..... m. bearing..... °M
12. Connection..... to..... m. bearing..... °M
13. Diff. Ht. 8.1 Pipe..... is 0.453. m. ^{above} ~~below~~ Trig. Plug. Note Bearing distances as from Station Summary
14. Diff. Ht. 56M..... is 0.258. m. ^{above} ~~below~~ Trig. Plug.....
15. Diff. Ht. is..... m. ^{above} ~~below~~
16. Diff. Ht. is..... m. ^{above} ~~below~~

Prepared by: P. Healdon
 Checked: SA

