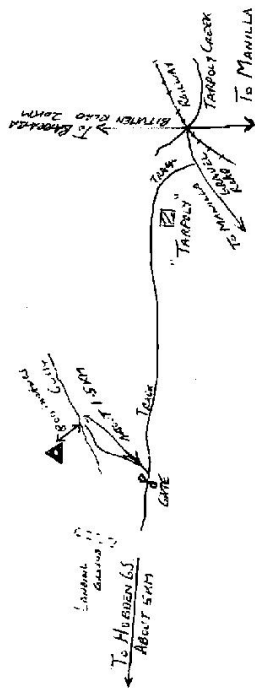


STATION TARPOLY TS 4293	Owner's Name: Current Occupant: Address: Phone: ACCESS Access Report of <u>L.J. 1198</u> was found suitable/unusable. NB <u>TRAIL MARK DESTROYED</u> 0.000 P.O. BARBARA TRAVEL SOUTH. 20.4 TURN WEST ALONG GRAVEL ROAD 21.2 TURN NORTH ALONG TRACK 22.3 "TARPOLY" HOMEHEAD 26.5 (APPROXIMATELY) GATE. THERE IS A LANDING GROUNDS START BEHIND GATE FOLLOW TRACK NORTH FROM GATE 28.0 END OF TRACK. WHEN FIRST END OF TRACK (AT GATE) TO TAIL IS ABOUT 0.8 KM
Beacon Diagram Not to Scale	
This section to be completed by officer constructing pillar. Original station mark found/not found.	Description of mark: Original beacon found/not found.
Description of beacon:	Height Top of Vanes to Top Markm. Height of markm. above G.L. below Diameter of Vanesm. Height of Cairnm. Original Beacon has/has not been destroyed by ma.
Date	Record of Station