

CENTRAL MAPPING AUTHORITY
Department of Lands

Trigonometrical Survey of N.S.W.

RECONNAISSANCE and MAINTENANCE REPORT

This Trig. Station has been:-

Note: Cross out word or words which do not apply

1. Completely cleared to permit 360° vision to surrounding Trigs.
2. ~~Cleared by top of mast~~ from Trig. Mast
3. Trig. Mast & Vanes have been painted white & black respectively.
4. The Trig. was ~~unpiled~~/not unpiled, dimensions now being:

Description of mark..... should be explicit, e.g. Steel plug, Brass plug, Bolt, G.I. Pipe

Height of mark..... m above rock/concrete..... m above G.L.

Height of Top Vanes to Top Mark..... m Diameter of Vanes (vertical) 1.015 m.

Height of Cairn..... m. Diameter of Cairn..... m.

Length of Mast..... m. (approximate if not unpiled)

5. A. S.S.M. set in conc/rock has been placed found 3.345 m. bearing 98°M from Trig. Mast

6. A..... set in conc/soil has been placed..... m. bearing.....°M from Trig. Mast

7. A..... set in conc/soil has been placed..... m. bearing.....°M from Trig. Mast

8. A..... set in conc/rock has been placed..... m. bearing.....°M from Trig. Mast

9. Connection. S.S.M. to G.I. Pipe: 6.292 m. bearing 260°M

10. Connection..... to..... m. bearing.....°M

11. Connection..... to..... m. bearing.....°M

12. Connection..... to..... m. bearing.....°M

13. Diff. Ht. S.S.M. in concrete is 0.105 m. below G.I. Pipe in concrete

14. Diff. Ht. S.S.M. in concrete is 3.465 m. below Top of Vanes

15. Diff. Ht. is..... m. above below

16. Diff. Ht. is..... m. above below

Prepared by: John R. Williams Checked: John R. Williams

Noted on U.T.M. Card 11/3/75

Checked: John R. Williams 6/1/75

STATION TAUNTON TS 4297


Co: HARDINGE PH: DAREY

Map Sheet: BUNDARA No: 19137

Inspected by: J.R. Wallace Date: 27-11-74

Authority C.M.A. Field Book: 1369

Beacon Diagram Not to Scale

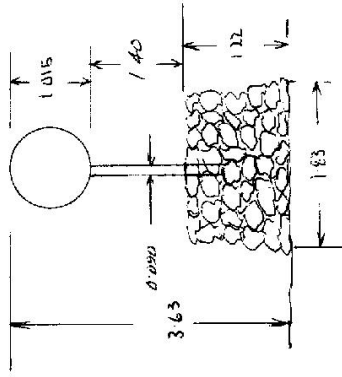

Date


Record of Station

Current Occupant.....

Address.....

Owners Name.....
Address.....

Access

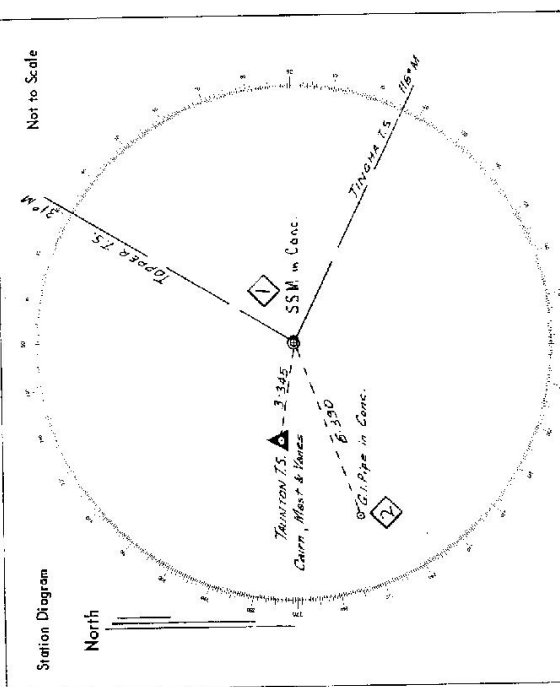

List of Observed Directions:—

Standpoint: S.S.M. in Concrete

Station	Direction	Station	Direction
TOPPER T.S.	327.59.60		
E.I. Pipe in Cove	329.25.20		
Centre of Mast	347.08.30		

STATION: TAUNTON C.S.		No.: 4297	
MAP SHEET SCALE 1:250 000		MANILLA SH 56-9	
INSPECTED BY: K. THOMPSON		DATE: 24-6-78	
AUTHORITY: C.M.A.		FIELD BOOK: —	

Station Diagram

North

Not to Scale

required station with parking during

Checked

STATION TAUNTON C.S. TS 4297

GEODETIC SURVEY OF N.S.W.

GEODETTIC STATION RECONNAISSANCE and MAINTENANCE REPORT

Description:

Note: Cross out word or words which do not apply

1. Cleared by lanes bearing Observed by rearview from Trig, Mast

Note: Cross out word or words which do not apply
~~anyone~~..... from Trig, Mast

2. Mast & Vanes have been painted white & black respectively.

3. The station/pillar was unpiled/not unpiled/constructed on.....19....., dimensions now being:

Description of mark.....should be explicit, e.g., S/Steel Pillar Plate, Steel plug, Bolt, G.I. Pipe

Height of mark,.....m, ^{above} rock/concrete;
Mark is.....m, ^{above} G.L.

Height of Top Vane to Top Mark/Pillar plate m.
Diameter of Vane (vertical) 0.9 m.

Height of Cairn.....1.5.....m.
Diameter of Cairn.....20.....m.
Name Plate found/not found/placed.

Length of Mast 3.5-
(approximate if not unplied)

4. A G 1 Pipe set in conc/feet has been placed/ found, bearing..... ° M from Mast/Plug/Pillar

5. A..... set in conc/veek has been place/found, bearing.....^oM from Mast/Plug/Pillar

5. A.....set in conc/rock has been placed/found, bearing.....°M from Mast/Plug/Pillar

7. A.....set in conc/rock has been placed/found, bearing.....° M from Mast/Plug/Pillar

8. Action required: Clean suction and top by going to give 360° check.
Construct rooftop drain. Scaffolding - required.

[illegible]

Noted on U. T. M. Card

Checked: _____

Prepared by:

2733-1

STATION: TAUNTON	No.: 4297
MAP SHEET SCALE 1:250 000	
INSPECTED BY: A. C. ARSINE	DATE: 8/7/32
AUTHORITY: C. M. B.	FIELD BOOK: 2007

Station Diagram

North

Vegetation on hill is regrowth of previously cleared pines

Not to Scale

COPPER 30°

LONGCOTT 90°

TOWNE 115°

DREYFORD 205°

GUTHRIE 225°

MARE 253°

HOWELL 270°

Beacon Diagram	Not to Scale	STATION TAUNTON TS 4297
		Owner's Name: <u>Mrs. Helen Carpenter</u>
		Address: <u>"Pumpkin Patch"</u>
		Phone: <u>067 23 3843</u>
		Current Occupant:
		Address:
		Phone:
		ACCESS 8-7-1942
		Access Report of <u>24/6/1942</u> was found suitable/in-suitable.
<p><u>Km</u></p> <p><u>0.0</u> ... <u>Recieve</u></p> <p><u>0.6</u> ... <u>LIVERELL PC TRAVELLING TOWARDS CLEVER VILLAGES</u></p> <p><u>20.8</u> ... <u>TURN RIGHT TOWARDS BUILDINGS</u></p> <p><u>27.0</u> ... <u>TURN LEFT TOWARDS TUNNUP AT LINDSAYROADS</u></p> <p><u>29.0</u> ... <u>TURN RIGHT ONTO "GOLE ROAD" TOWARDS BUILDINGS</u></p> <p><u>33.1</u> ... <u>END OF SEALED ROAD</u></p> <p><u>33.4</u> ... <u>TURN RIGHT INTO PROPERTY "PROPERTY"</u></p> <p><u>33.8</u> ... <u>DONALD WOODEN GATES PASS HOUSE ON RIGHT</u></p> <p><u>34.9</u> ... <u>DONALD WOODEN GATES</u></p> <p><u>36.1</u> ... <u>TURN RIGHT THROUGH AGGATE IRON GATES YIELD TO USUAL FROM HERE MAKE WAY AROUND Paddock TO FENCE</u></p> <p>... <u>DONALD IRON GATE TURN LEFT ALONG FENCE AND DRIVE TO ROSE OF HILL</u></p> <p>... <u>IGNORANT WALK TO TOP OF HILL</u></p>		
<p>This section to be completed by officer constructing pillar.</p> <p>Original station mark found/not found.</p> <p>Description of mark:</p> <p>Original beacon found/not found.</p> <p>Description of beacon:</p> <p>Height Top of Vanes to Top Mark m.</p> <p>Height of mark m. above G.L. below</p> <p>Diameter of Vanes m. Height of Cairn m.</p> <p>Original Beacon has/has not been destroyed by me.</p>		Record of Station
		Date

LAND INFORMATION CENTRE

GEODETTIC SURVEY OF N.S.W.

GEODETTIC STATION RECONNAISSANCE and MAINTENANCE REPORT

Description:

1. Cleared by lanes bearing..... Clear For C.P.S. Note: Cross out word or words which do not apply

2. Mast & Vanes have been painted white & black respectively.

3. The station/pillar was unpiled/not unpiled/constructed on..... 19....., dimensions now being:

Description of mark..... should be explicit, e.g., S/Steel Pillar Plate, Steel plug, Brass plug, Bolt, G.I. Pipe

Height of mark.....m. above rock/concrete; Mark is.....m. above below G.L.

Height of Top Vanes to Top Mark/Pillar platem. Diameter of Vanes (vertical).....m.

Height of Cairn.....m. Diameter of Cairn.....m. Name Plate found/not found/placed.

Length of Mastm. (approximate if not unpiled)

4. A.....set in conc/rock has been placed/found, bearing.....°M from Mast/Plug/Pillar

5. A.....set in conc/rock has been placed/found, bearing.....°M from Mast/Plug/Pillar

6. A.....set in conc/rock has been placed/found, bearing.....°M from Mast/Plug/Pillar

7. A.....set in conc/rock has been placed/found, bearing.....°M from Mast/Plug/Pillar

8. Action required:.....

STANDPOINT:

STANDPOINT:

Mark	Direction	Horiz. Distance	Height Difference	Mark	Direction	Horiz. Distance	Height Difference
			above standpt.				above standpt.
			below				below
			above standpt.				above standpt.
			below				below
Prepared by: D. Kain

Checked:

Noted on U.T.M. Card

Checked

: 2733-1

STATION: <u>TAUNTON G.S.</u>		No.: <u>4297</u>	
MAP SHEET SCALE 1:250 000		<u>Manilla</u>	
INSPECTED BY: <u>D. J. Kain</u>		DATE: <u>22.2.91</u>	
AUTHORITY: <u>L. I. C.</u>		FIELD BOOK: <u>N.L.</u>	

Station Diagram

Not to Scale

North

New Access only.

+

Beacon Diagram

(No Need to Contact
OWNER April - May 1991)

Not to Scale