

CENTRAL MAPPING AUTHORITY

Department of Lands

Trigonometrical Survey of N.S.W.

RECONNAISSANCE and MAINTENANCE REPORT

STATION **TERMINUS TS 4316**

Pl: **Cookardimra**

This Trig. Station has been:-

Note: Cross out word or words which do not apply

1. Completely cleared to permit 360° vision to surrounding Trigs.

2. Cleared by limes bearing from Trig. Mast

3. Trig. Mast & Vanes have been painted white & black respectively.

4. The Trig. was unpiled/not unpiled, dimensions now being: ~~.....~~ **.....**

Description of mark..... should be explicit, e.g. Steel plug, Brass plug, Bolt, Sol. Pipe

Height of mark..... m ^{above} _{below} rock/concrete **E.L.**

Height of Top Vanes to Top Mark..... m. Diameter of Vanes (vertical)..... m.

Height of Cairn..... m. Diameter of Cairn..... m.

Length of Mast..... m. (approximate if not unpiled) **A B C**

5. A..... set in conc/rock has been placed..... m. bearing.....°M from Trig. Mast

6. A..... set in conc/soil has been placed..... m. bearing.....°M from Trig. Mast

7. A..... set in conc/soil has been placed **A P P L E**..... m. bearing.....°M from Trig. Mast

8. A..... set in conc/rock has been placed..... m. bearing.....°M from Trig. Mast

9. Connection..... to..... m. bearing.....°M

10. Connection..... to..... m. bearing.....°M

11. Connection..... to..... m. bearing.....°M

12. Connection..... to..... m. bearing.....°M

13. Diff. Ht. is..... m. ^{above} _{below} **N O**

14. Diff. Ht. is..... m. ^{above} _{below}

15. Diff. Ht. is..... m. ^{above} _{below}

16. Diff. Ht. is..... m. ^{above} _{below}

Prepared by:

Checked:

Noted on U.T.M. Card

Checked

Date

Record of Station

Not to Scale

Co: **Goulburn**

Map Sheet: **Holbrook**

Inspected by: **G. Hanna**

Authority: **Beacon Diagram**

No: **8326-N**


Date: **22/9/76**

Field Book:

7-1-88

STATION **TERMINUS TS 4316**

Owners Name.....
 Current Occupant.....
 Address.....
 Address.....

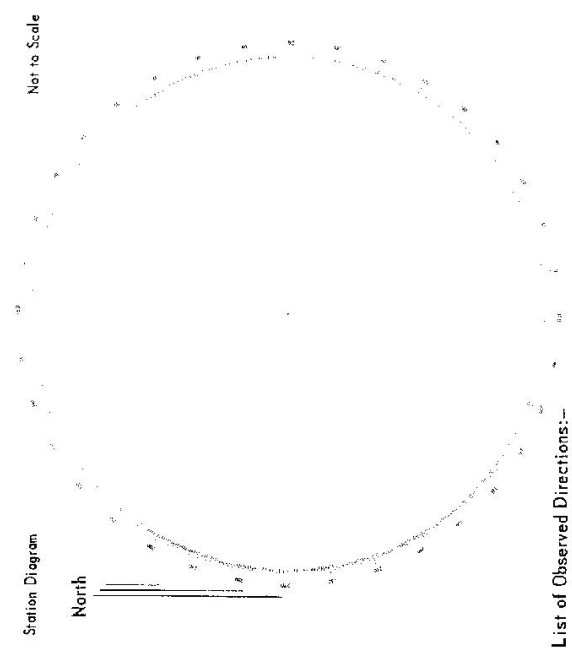

List of Observed Directions:-

Standpoint:		Standpoint:	
Station	Direction	Station	Direction

