



© Other than for the purpose of research or fair dealing no part of this data may be reproduced by any means without prior written permission.

LOCALITY SKETCH PLAN


PM T.S 4318

~~SSM~~ T.S TERRACE

Description


Parish ELDON County GLOUCESTER Town/Suburb/Locality RAYMOND TERRACE
Local Government Area PORT STEPHENS LIC Map Sheet RAYMOND TERRACE U6372-1X

T.S 4318 Cross-section
"TERRACE"

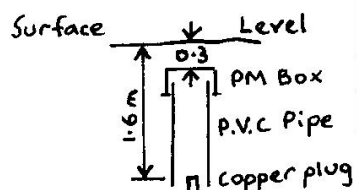

"TERRACE"

T.S 4318 has a PM Cover Box
it is 0.3 under ground

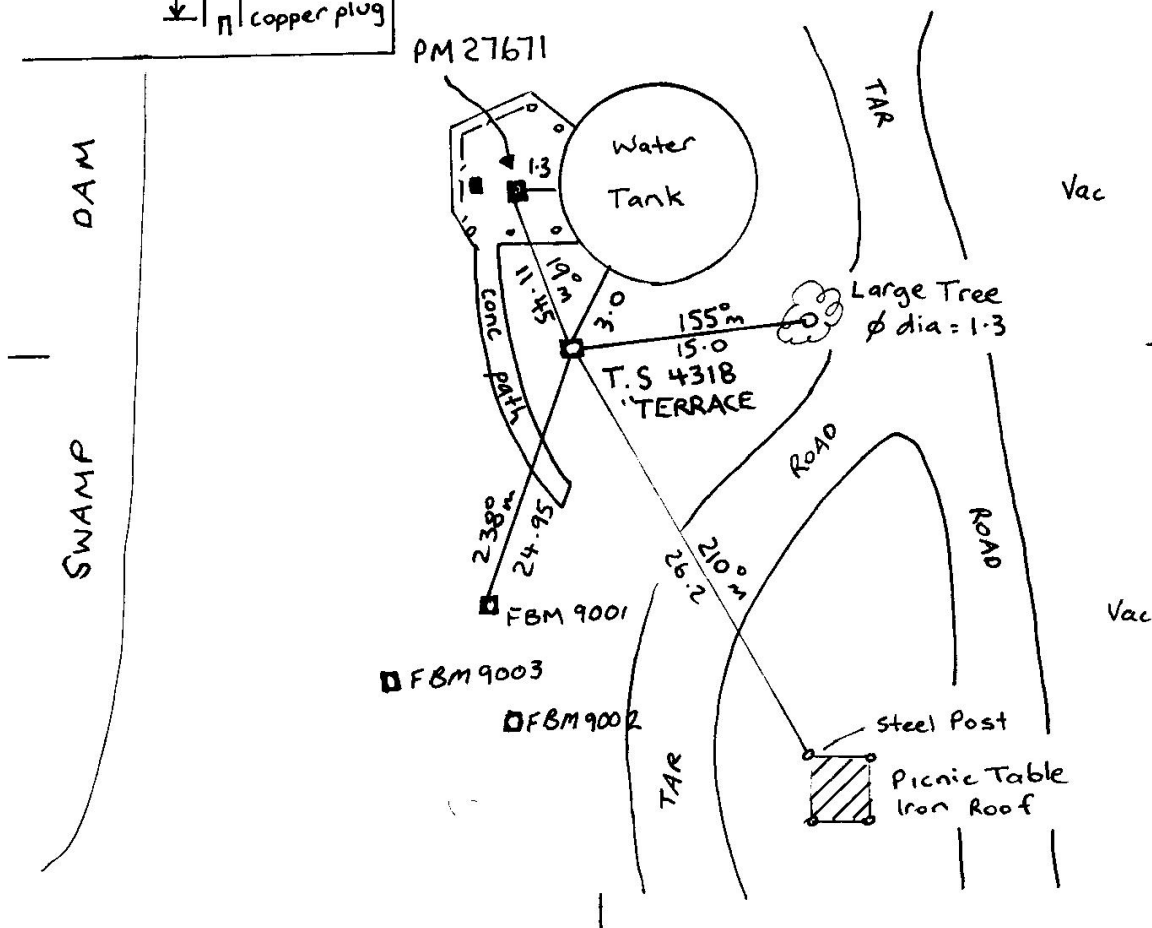

Please use black ink only

SURVEY PRACTICE REGULATION			1990
MARK	AHD	SOURCE	DATE
HEIGHT DETERMINED BY		DIFF. LEVELLING	
(specify)		TRIG. HEIGHTING	
ADOPTED MARKS			

Measurements are in metres

I certify that the Mark or Marks have been placed and numbered as detailed hereon

PM T.S 4318

~~SSM~~ T.S TERRACE

Signed Alfred
Mark placed 17 / 5 / 96

PM Organization placing marks

Replaces

SSM

Ref