


GEODETTIC SURVEY OF N.S.W.

CENTRAL MAPPING AUTHORITY

GEODETTIC STATION RECONNAISSANCE and MAINTENANCE REPORT

Description:


1. Cleared by lanes bearing *See diagram* Note: Cross out word or words which do not apply
2. Mast & Vanes have been painted white & black respectively.
3. The station/pillar was unpiled/not unpiled/constructed on *19* dimensions now being:
 Description of mark should be explicit, e.g. S/Steel Pillar Plate, Steel plug, Brass plug, Bolt, G.I. Pipe
 Height of mark above *rock/concrete* below *G.L.*
 Height of Top Vanes to Top Mark/Pillar plate *0* m. Diameter of Vanes (vertical) *0* m.
 Height of Cairn *0* m. Diameter of Cairn *0* m. Name Plate found/not found/placed.
 Length of Mast *0* m. (approximate if not unpiled)
4. A *0* set in conc/rock has been placed/found, bearing *0* M from Mast/Plug/Pillar
5. A *0* set in conc/rock has been placed/found, bearing *0* M from Mast/Plug/Pillar
6. A *0* set in conc/rock has been placed/found, bearing *0* M from Mast/Plug/Pillar
7. A *0* set in conc/rock has been placed/found, bearing *0* M from Mast/Plug/Pillar
8. Action required: *No action*

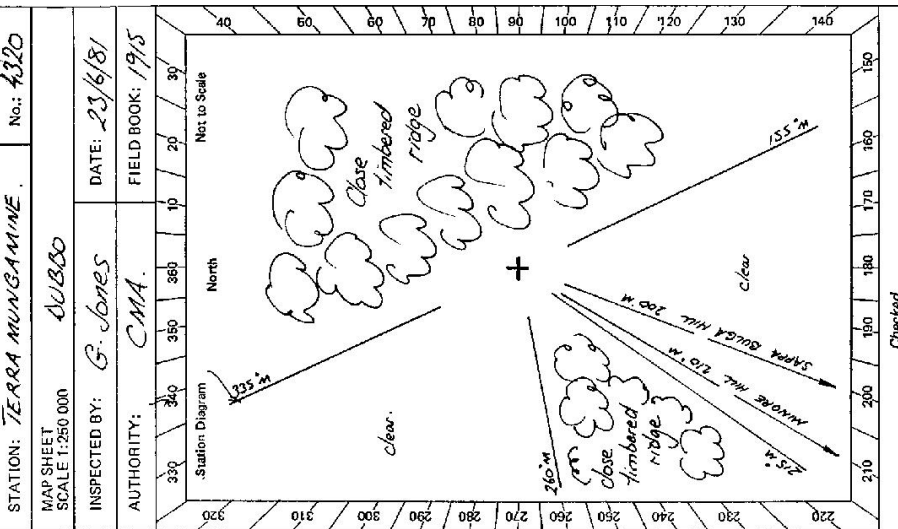

STANDPOINT:

Mark	Direction	Horiz. Distance	Height Difference	Mark	Direction	Horiz. Distance	Height Difference
			above standpt.				above standpt.
			below standpt.				below standpt.
			above standpt.				above standpt.
			below standpt.				below standpt.
Prepared by: *GL* 20/7/81 Checked: *L. Angus* 21.7.81 Noted on U.T.M. Card

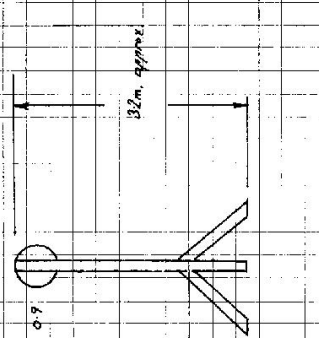STATION TERRAMUNGAMINE TS 4320	Owner's Name: Bill BAILEY Address: "CHELSEA" Phone: 886 access Current Occupant: Address: Phone: ACCESS Access Report of 15/10/75 was found suitable/unsuitable. 0-0 Railway crossing in DURBO, on Newell Hwy towards Gilgandra. 0-15 Turn right. Sign: "Gilgandra" 0-35 Turn left. Sign: "Gilgandra" 7-5 AT BROCKLEHURST. Stay on Newell Hwy. 180 Pass road on left to Terramungamine N.H. (Chelsea down this road on the right.) 190 Trg is in paddock on LHS. at top of hill. (over fence)
Beacon Diagram Not to Scale  <p style="text-align: center;"><i>No court wooden supports only</i></p>	This section to be completed by officer constructing pillar. Original station mark found/not found. Description of mark: Original beacon found/not found. Description of beacon: Height Top of Vanes to Top Mark m. Height of mark m. above G.L. below Diameter of Vanes m. Height of Cairn m. Original Beacon has/has not been destroyed by me. <input checked="" type="checkbox"/>
Date	Record of Station Station is not suitable for mapping or geodetic purposes.