

STATION T.S. ~~PLEASANT~~ ~~PILLAR~~ #552


Owners Name: M. Laneagan
 Current Occupant: M. Laneagan

Address: 47 Thorndale
 Address:

Via: Muswellbrook

- Access 21-11-1977
 Km. Feature.
- 0.0 Muswellbrook P.O. Follow New England Hwy Northwards Scene.
 - 1.0 Turn left onto Sandy Hollow Road.
 - 1.6 Turn right over bridge - follow road to Kanyuga and Aberdeen.
 - 6.0 Turn left onto Castle Rock Rd
 - 11.7 At top of hill - Turn onto on L.H.S. beside large bridge here - enter and follow track.
 - 13.4 Wooden Gate - follow track to top of hill
 - 13.8 P.O.G.

Access by conventional vehicle.

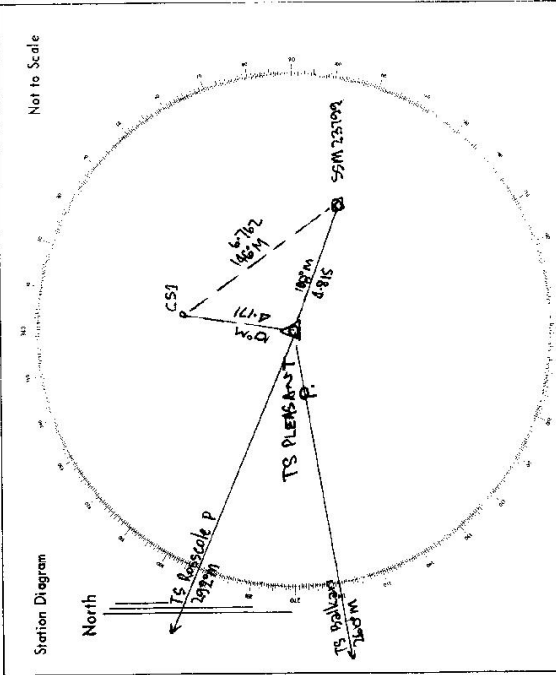

List of Observed Directions:-

Stationpoint: 1140y Plate		Stationpoint: SSM 23799	
Station	Direction	Station	Direction
TS Balkany	0° 00' 00"	TS Pleasant P	0° 00' 00"
TS Rosedale P	37° 58' 58.5"	Copper Spikes	37° 42' 01"
CS	110° 04' 10"		
SSM 23799	207° 27' 40.5"		
Station	Direction	Station	Direction