


STATION THALGONA TS 4365

Owners Name.....
 Current Occupant.....
 Address.....
 Address.....

Access Dec 1974
 CONVENTIONAL VEHICLE IN DRY WEATHER

TAKE KNOBLES ROAD OFF RUNDUNA HIGHWAY APPROX 5.8 MILES EAST OF ALBURY. FOLLOW TO HANKSVIEW ROAD ON LEFT AT 2.35 MILES. TAKE HANKSVIEW ROAD TO GATE AT 0.5 MILES AND TO GATE ON RIGHT AT A FURTHER 0.05 MILES. THROUGH GATE AND FOLLOW FRONT TRACK AROUND RIDGE TO SPUR HEADING EAST AT 0.7 MILES UP TO SPUR TO TS 0.55 MILES

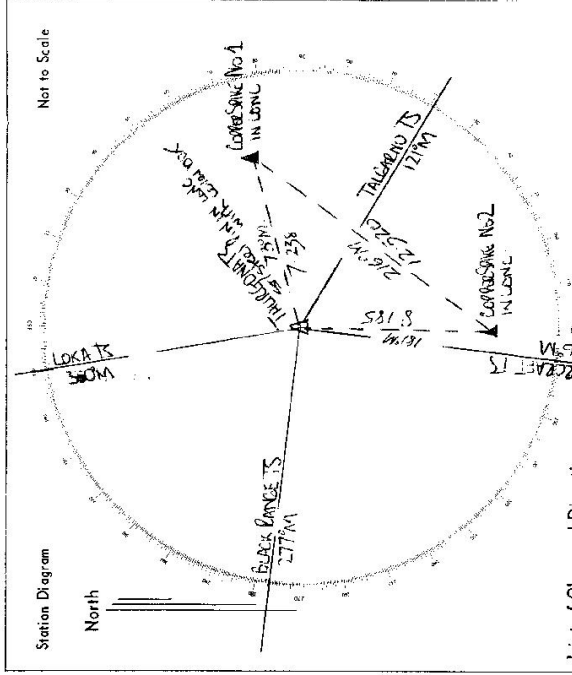

List of Observed Directions:-

Station	Direction	Station	Direction
BLACK RANGE TS	559 57 60	THALGONA TS	350 57 60
LOKA TS	74 10 00	LOPES SNAKE NO 1	35 16 27
LOPES SNAKE 1	153 57 10		
THALGONA TS	240 38 45		
ALBURY TS	763 19 74		
LOPES SNAKE 2			
est steel pin			

Station	Direction	Station	Direction
THALGONA TS	350 57 60		
ALBURY TS	55 57 44 S		
BLACK RANGE TS	141 21 14		
LOKA TS	200 49 21 2		

Standpoint: COPPED SNAKE 2

Standpoint: ST 15002 PIN