

GEODETTIC SURVEY OF N.S.W.

CENTRAL MAPPING AUTHORITY

GEODETTIC STATION RECONNAISSANCE and MAINTENANCE REPORT

Description:

1. Cleared by lanes bearing..... Note: Cross out word or words which do not apply from Trig. Mast

2. Mast & Vanes have been painted white & black respectively.

3. The station/pillar was unpiled/not unpiled/constructed on..... dimensions now being:

Description of mark..... should be explicit, e.g., S/Steel Plate, Steel plug, Brass plug, Bolt, G.I. Pipe

Height of mark.....m. above below rock/concrete; Masts

Height of Top Vanes to Top Mark/Pillar plate.....m. Diameter of Vanes (vertical).....m.

Height of Cairn.....m. Diameter of Cairn.....m. Name Plate found/not found/placed.

Length of Mast.....m. (approximate if not unpiled)

4. A..... set in conc/rock has been placed/found, bearing.....°M from Mast/Plug/Pillar

5. A..... set in conc/rock has been placed/found, bearing.....°M from Mast/Plug/Pillar

6. A..... set in conc/rock has been placed/found, bearing.....°M from Mast/Plug/Pillar

7. A..... set in conc/rock has been placed/found, bearing.....°M from Mast/Plug/Pillar


8. Action required:.....

STANDPOINT: SPRINGESS STEEL TRIG. PLUG. ✓ STATION: SSM in conc (damaged) ✓

Mark	Direction	Horiz. Distance	Height Difference	Mark	Direction	Horiz. Distance	Height Difference
DROMEDARY G.S.	0 00 00		above standpt	DROMEDARY G.S.	0 00 00		above standpt
TILBA TILBA SSM	105 46	2.776	above standpt	TILBA TILBA SSM	105 40 09		above standpt
8925-0006 L.A.	105 39 /85		above standpt	8925-0006 L.A.	105 40 09		above standpt
TILBA TILBA G.I. PIPE	244 28 30	3.614	above standpt	TILBA TILBA G.I. PIPE	261 19 00	5.986	above standpt
			below standpt	TILBA TILBA S.S.M.	285 49	2.776	below standpt
			above standpt				above standpt
			below standpt				below standpt
			above standpt				above standpt
			below standpt				below standpt

Prepared by: G. Dickson 22-3-85 Checked: 22/3/1985 Noted on U.T.M. Card

Checked

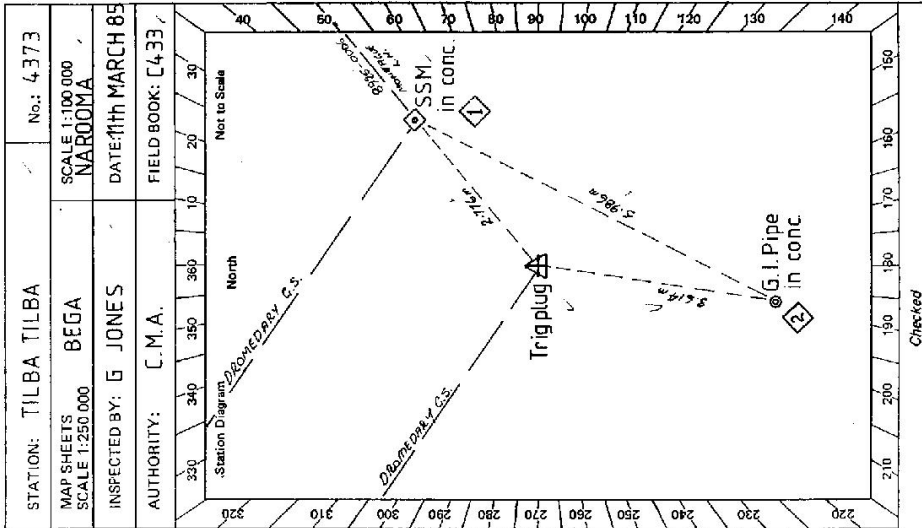

8c2738-2 D. West, Government Printer

STATION TILBA TILBA GS TS 4373

Owner's Name: MR. N.C. HOYER Current Occupant:

Address: Address:

Phone: Phone:

ACCESS

Access Report of 12/1987 was found suitable/unsuitable.

FEATURE

KM. 0.00. DROMEDARY HOTEL CENTRAL TILBA HEADS EAST

0.13 TURN LEFT ONTO PACIFIC HIGHWAY

0.53 TURN RIGHT THEN SHERRINGHAM LANE

1.59 TURN RIGHT

1.83 PASS ROAD ON RIGHT

2.57 GRID


3.37 OWNERS HOUSE ON RIGHT (CALL IN).

3.56 IRON GATE SIGN "NO CAMPING"

4.06 WIRE GATE SIGN ON FENCE "PRIVATE PROPERTY KEEP OUT"

4.62 TURN LEFT OFF MAIN TRACK & FOLLOW EDGE OF CLIFF GROUND TO TRIC

4.90 TILBA TILBA GS.

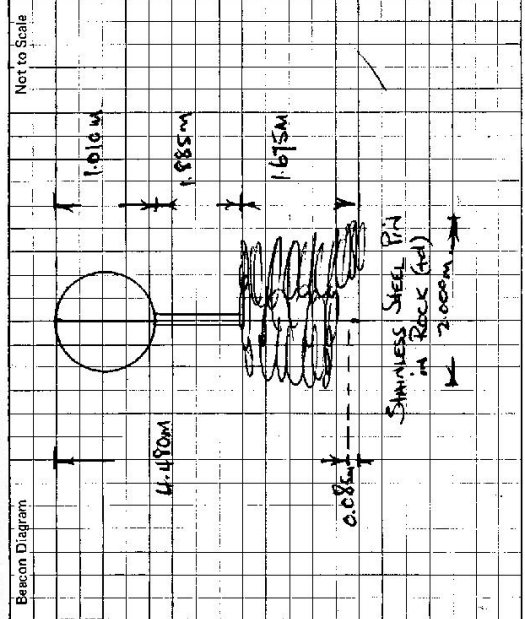

This section to be completed by officer constructing pillar.

Original station mark found/not found.

Description of mark:

Original beacon found/not found.

Description of beacon:

Height Top of Vanes to Top Mark.....m.

above G.L. below

Height of mark.....m. rocks/conc.....m. below

Diameter of Vanes.....m. Height of Cairn.....m.

Original Beacon has/has not been destroyed by me.

Date	Record of Station