


1/2/19

Department of Lands
 RECONNAISSANCE and MAINTENANCE REPORT 4398
 STATION Tomaree (ATS) 4398
 Co: Gloucester
 Ph: Tomaree

Map Sheet:
 Inspected by: P. McBeath
 Authority: Interpretation Surveys
 No: 10-3-76
 Date: 10-3-76
 Field Book: PIP 324

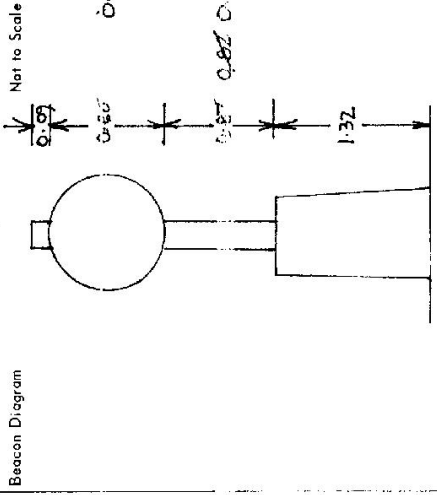

Date	Record of Station
1.3.76	Pillar erected
18.12.82	Old mast and vane erected
21.6.85	New mast and vane erected

Note: Cross out word or words which do not apply

This Trig. Station has been:

1. Completely cleared to permit 360° vision to surrounding Trigs.
2. Cleared by lances bearing.
3. Trig. Mast & Vanes have been painted white & black respectively ✓
4. The Trig. was unplied/~~replaced~~, dimensions now being:
 - Description of mark: Concrete Pillar (should be explicit, e.g. Steel plug, Brass plug, Bal, Concrete Pillar)
 - Height of mark: 1.32 m above rock/concrete (1.32 m above G.L.)
 - Height of Top Vanes to ~~mark~~ Top pillar plate: 1.42 m Diameter of Vanes (vertical): 0.60 m.
 - Height of Cairn: m. Diameter of Cairn: m.
 - Length of Mast: 1.56 m. (approximate if not unplied)
5. A Trig Plug set in conc. ~~rock~~ has been placed/fd 2.46 m. bearing 122° M from Trig. ~~stone~~ pillar
6. A SSM 8720 set in conc./~~soil~~ has been placed/fd 3.787 m. bearing 153° M from Trig. ~~stone~~ pillar
7. A set in conc./soil has been placed/fd m. bearing °M from Trig. Mast/pillar
8. A set in conc./rock has been placed/fd m. bearing °M from Trig. Mast/pillar
9. Connection SSM 8720 Trig Plug: 2.268 m. bearing 195° M
10. Connection: to m. bearing °M
11. Connection: to m. bearing °M
12. Connection: to m. bearing °M
13. Diff. Ht. Trig Plug is 1.216 m. ^{below} Pillar Plate
14. Diff. Ht. SSM 8720 is 1.063 m. ^{below} Pillar Plate
15. Diff. Ht. is m. ^{above}
16. Diff. Ht. is m. ^{above}

Prepared by: L.M. Hayes Checked: *[Signature]*

GEODETIC SURVEY OF NSW

CENTRAL MAPPING AUTHORITY

GEODETIC STATION RECONNAISSANCE and MAINTENANCE REPORT

Description:

1. Cleared by lanes bearing.....
Note: Cross out word or words which do not apply
2. Mast & Vanes have been painted white & black respectively.
3. The station/pillar was unpiled/not unpiled/constructed on.....
Description of mark.....should be explicit, e.g., S/Steel Pillar Plate, Steel plug, Brass plug, Bolt, G.I. Pipe
Height of mark.....m.....^{above} _{below} rock/concrete; Mark is.....m.....^{above} _{below} G.L.
Height of Top Vanes to Top Mark/Pillar plate.....m. Diameter of Vanes (vertical).....m.
Height of Cairn.....m. Diameter of Cairn.....m. Name Plate found/not found/placed.
Length of Mast.....m. (approximate if not unpiled)
4. A.....set in conc/rock has been placed/found, bearing.....°M from Mast/Plug/Pillar
5. A.....set in conc/rock has been placed/found, bearing.....°M from Mast/Plug/Pillar
6. A.....set in conc/rock has been placed/found, bearing.....°M from Mast/Plug/Pillar
7. A.....set in conc/rock has been placed/found, bearing.....°M from Mast/Plug/Pillar
8. Action required:.....

STANDPOINT:

Mark	Direction	Horiz. Distance	Height Difference	Mark	Direction	Horiz. Distance	Height Difference
			below	standpt.			above
			below	standpt.			below
			below	standpt.			below
Prepared by: *Alan Wood*

9/6/89

Checked:

Noted on U.T.M. Card

Checked

STATION: **TOMAREE (P)** No.: **TS 4398**
 MAP SHEETS SCALE 1:250 000
 INSPECTED BY: **SCB SYDNEY** DATE: **1-6-89**
 AUTHORITY: FIELD BOOK:

North
 Not to Scale
MAST & VANES REPLACED
1/6/89
 (see new dimensions overleaf)

+

GS 24

STATION TOMAREE IS 4398	Owner's Name: Address: Phone: Current Occupant: Address: Phone: Access Report of/IS.....was found suitable/unsuitable. ACCESS:
Beacon Diagram:	<p style="text-align: center;">Not to Scale</p> <p style="text-align: center;">TOMAREE (P)</p> <p style="text-align: center;">0.09 0.75 0.99</p>
This section to be completed by officer constructing pillar. Original station mark found/not found.	
Description of mark: Original beacon found/not found.	
Description of beacon: Height Top of Vanes to Top Mark.....m. Height of mark.....m. above rock/conc.....m. below G.L. Diameter of Vanes.....m. Height of Cairn.....m. Original Beacon has/has not been destroyed by me.	
Date	Record of Station

STATION TOMARY T.S. 4398

Current Occupant.....


Address.....

Owners Name.....

Address.....

Access Conventional Vehicle 10-3-1976

Approx 1km from Nelson Bay (heading towards Newcastle)
 turn right towards Gan Gan Scenic Lookout (signposted)
 drive along bitumen road to lookout. Leave vehicle
 and 3minute leisurely walk past Towers to T.S.

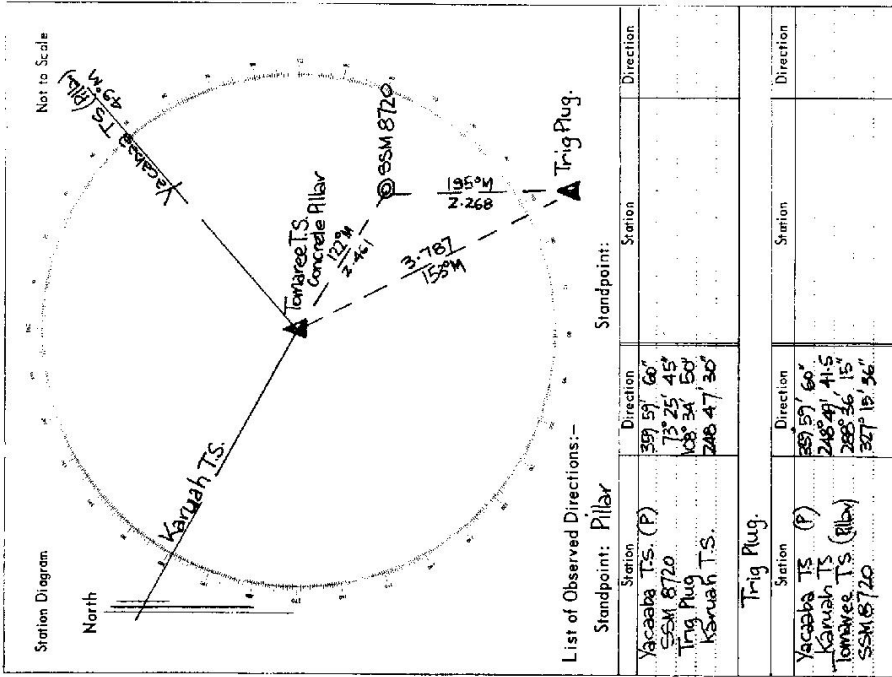

List of Observed Directions:-

Standpoint: Pillar		Standpoint: Trig Plug	
Station	Direction	Station	Direction
Yacaaba T.S. (P)	359 59' 60"	Yacaaba T.S. (P)	359 59' 60"
SSM 8720	73 25' 45"	Karuah T.S. (P)	248 41' 15"
Trig Plug	108 34' 50"	Tomaree T.S. (Pillar)	208 36' 15"
Karuah T.S.	248 47' 30"	SSM 8720	327 18' 56"