

CENTRAL MAPPING AUTHORITY

GEODETIC SURVEY OF M.S.K.


GEODETIC STATION RECONNAISSANCE and MAINTENANCE REPORT

STATION: **TOMBONG** No.: **4399**

MAP SHEET
SCALE 1:250 000 **BE 6A**

INSPECTED BY: **G. C. HANNA** DATE: **25 - 4 - 80**

AUTHORITY: **C. M. A.** FIELD BOOK:

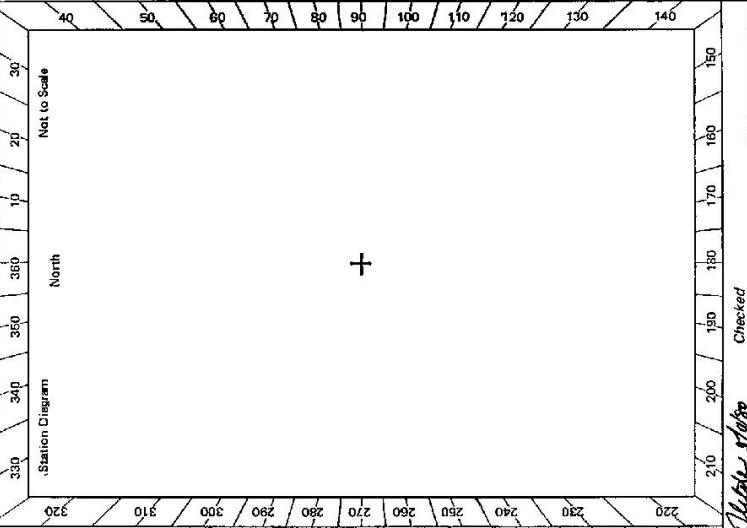

- Description:
- Cleared by lanes bearing..... from Fig. Mast
Note: Cross out word or words which do not apply
 - Mast & Vanes have been painted white & black respectively.
 - The station/pillar was unpiled/not unpiled/constructed on.....¹⁹..... dimensions now being:
Description of mark..... should be explicit, e.g., S/Steel Pillar Plate, Steel plug, Brass plug, Bolt, G.I. Pipe
Height of mark.....^{above} rock/concrete; Mark is.....^{above} G.L.
Height of Top Vanes to Top Mark/Pillar plate.....^{below}.....m. Diameter of Vanes (vertical).....m.
Height of Cairn.....m. Diameter of Cairn.....m. Name Plate found/not found/placed.
Length of Mast.....m. (approximate if not unpiled)
 - A..... set in conc/rock has been placed/found, bearing.....° M from Mast/Plug/Pillar
 - A..... set in conc/rock has been placed/found, bearing.....° M from Mast/Plug/Pillar
 - A..... set in conc/rock has been placed/found, bearing.....° M from Mast/Plug/Pillar
 - A..... set in conc/rock has been placed/found, bearing.....° M from Mast/Plug/Pillar
 - Action required.....

STANDPOINT:				STANDPOINT:			
Mark	Direction	Horiz. Distance	Height Difference	Mark	Direction	Horiz. Distance	Height Difference
			above standpt.				above standpt.
			below standpt.				below standpt.
			above standpt.				above standpt.
			below standpt.				below standpt.
Prepared by: *G. Hanna* 8 - S - 80 Checked: *G. Hanna* 27/8/80 Noted on U.T.M. Card
Checked: *G. Hanna* 27/8/80

et. 27332-2 D. West. Government Printer

Beacon Diagram	Not to Scale	STATION	TOMBONG	TS	4-399																																				
<table border="1"><tr><td>Owner's Name:</td><td>Current Occupant:</td></tr><tr><td>Address:</td><td>Address:</td></tr><tr><td>Phone:</td><td>Phone:</td></tr><tr><td colspan="2"><u>ACCESS</u> Access Report of 25/4/1980 was found suitable/unusable. <u>ACCESS</u> See also Tombong 8624-S</td></tr><tr><td colspan="2">Km</td></tr><tr><td>0-0</td><td>Delegate P.O. towards Victoria.</td></tr><tr><td>0-7</td><td>R.H. turn towards Currawong/Tombong.</td></tr><tr><td>16-4</td><td>End of sealed road.</td></tr><tr><td>19-2</td><td>Turn right into "Kalinga"</td></tr><tr><td>23-05</td><td>Take track to right around yards.</td></tr><tr><td>23-55</td><td>Gate.</td></tr><tr><td>23-6</td><td>Take track to right across creek.</td></tr><tr><td>24-2</td><td>Swing left before gate and follow track along fence up hill.</td></tr><tr><td>25-1</td><td>Swing left through gate & follow old track.</td></tr><tr><td>25-4</td><td>Dam on left.</td></tr><tr><td>26-1</td><td>Swing right & follow best course up ridge.</td></tr><tr><td>27-2</td><td>Swing left at fence line.</td></tr><tr><td>27-3</td><td>Fence intersection. Park vehicle & walk up ridge.</td></tr></table>		Owner's Name:	Current Occupant:	Address:	Address:	Phone:	Phone:	<u>ACCESS</u> Access Report of 25/4/1980 was found suitable/unusable. <u>ACCESS</u> See also Tombong 8624-S		Km		0-0	Delegate P.O. towards Victoria.	0-7	R.H. turn towards Currawong/Tombong.	16-4	End of sealed road.	19-2	Turn right into "Kalinga"	23-05	Take track to right around yards.	23-55	Gate.	23-6	Take track to right across creek.	24-2	Swing left before gate and follow track along fence up hill.	25-1	Swing left through gate & follow old track.	25-4	Dam on left.	26-1	Swing right & follow best course up ridge.	27-2	Swing left at fence line.	27-3	Fence intersection. Park vehicle & walk up ridge.	Owner's Name: Current Occupant: Address: Phone: <u>ACCESS</u> Access Report of 25/4/1980 was found suitable/unusable. <u>ACCESS</u> See also Tombong 8624-S Km 0-0 Delegate P.O. towards Victoria. 0-7 R.H. turn towards Currawong/Tombong. 16-4 End of sealed road. 19-2 Turn right into "Kalinga" 23-05 Take track to right around yards. 23-55 Gate. 23-6 Take track to right across creek. 24-2 Swing left before gate and follow track along fence up hill. 25-1 Swing left through gate & follow old track. 25-4 Dam on left. 26-1 Swing right & follow best course up ridge. 27-2 Swing left at fence line. 27-3 Fence intersection. Park vehicle & walk up ridge.			
Owner's Name:	Current Occupant:																																								
Address:	Address:																																								
Phone:	Phone:																																								
<u>ACCESS</u> Access Report of 25/4/1980 was found suitable/unusable. <u>ACCESS</u> See also Tombong 8624-S																																									
Km																																									
0-0	Delegate P.O. towards Victoria.																																								
0-7	R.H. turn towards Currawong/Tombong.																																								
16-4	End of sealed road.																																								
19-2	Turn right into "Kalinga"																																								
23-05	Take track to right around yards.																																								
23-55	Gate.																																								
23-6	Take track to right across creek.																																								
24-2	Swing left before gate and follow track along fence up hill.																																								
25-1	Swing left through gate & follow old track.																																								
25-4	Dam on left.																																								
26-1	Swing right & follow best course up ridge.																																								
27-2	Swing left at fence line.																																								
27-3	Fence intersection. Park vehicle & walk up ridge.																																								
This section to be completed by officer constructing pillar. Original station mark found/not found. Description of mark: Original beacon found/not found. Description of beacon: Height, Top of Vanes to Top Markm. Height of mark:m. above G.L. below rock/cont. below Diameter of Vanesm. Height of Cairnm. Original Beacon has/has not been destroyed by me.		Date Record of Station																																							