

74-88


STATION *TOOLONG G.S.* TS *4407*

Co: *KOSCIUSKO*

Map Sheet: *KOSCIUSKO* No: *8525*

Inspected by: *G. DICKSON* Date: *24-1-77*

Authority: *CENTRAL MAPPING* Field Book: *D1529*

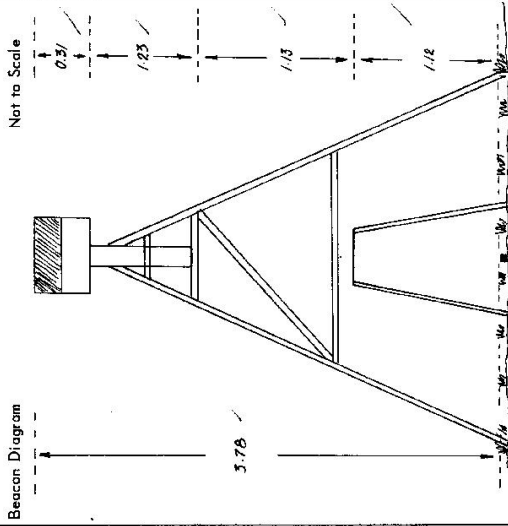

This Trig. Station has been:-
 Note: Cross out word or words which do not apply

1. ~~Completely cleared to permit 360° vision to surrounding Trig.~~
2. Cleaned by lanes bearing from Trig. Mast
3. Trig. Mast & Vanes have been painted white & black respectively--
4. The Trig. was unspiled/net unspiled, dimensions now being:
 Description of mark: STEEL OBS. PILLAR GRASS PILE should be explicit, e.g. Steel plug, Brass plug, Bolt, G.I. Pipe
 Height of mark: m above rock/concrete m below G.L.
 Height of Top Vanes to Top Mark: 3.70 m. Diameter of Vanes (vertical) 0.3 m.
 Height of Cairn: m. Diameter of Cairn m.
 Length of Mast: 1.54 m. (approximate if not unspiled)
5. A. set in conc/rock has been placed m, bearing°M from Trig. Mast
6. A. set in conc/soil has been placed m, bearing°M from Trig. Mast
7. A. set in conc/soil has been placed m, bearing°M from Trig. Mast
8. A. set in conc/rock has been placed m, bearing°M from Trig. Mast
9. Connection to m, bearing°M
10. Connection to m, bearing°M
11. Connection to m, bearing°M
12. Connection to m, bearing°M
13. Diff. Ht. is m, above
 below
14. Diff. Ht. is m, above
 below
15. Diff. Ht. is m, above
 below
16. Diff. Ht. is m, above
 below

Prepared by: *G. DICKSON* TS. Checked: *Alan Woodford* 13-4-77 Noted on U.T.M. Card

Checked: *Alan Woodford* 28/3/79


STATION **TOOLONG G.S. TS 4407**

Owners Name: **KO. SELLUSKO**
 Address: **NATIONAL PARK.**
 Current Occupant:
 Address:

NATIONAL PARKS KEY REQUIRED

- Access **24-1-1977**
- 0.0 km. KHANCOBAN - TRAVEL TOWARDS TAREBO ALONG ALPINE WAY ✓
 - 2.6 MURRAY 2 POWER STAY TURN OFF. ✓
 - 9.1 MURRAY 1 VIEWING AREA ✓
 - 10.1 MURRAY 1 POWER STATION TURN LEFT. ✓
 - 10.3 TURN RIGHT ALONG TRACK ✓
 - 10.6 GATE ✓
 - 11.5 TUNNEL ✓
 - 16.1 TAKE LEFT BRANCH IN TRACK. ✓
 - 16.6 TAKE LEFT BRANCH DARGALS FIRE TRAIL. ✓
 - 21.6 KEEP LEFT ON DARGALS FIRE TRAIL GRANITE KNOB TRAIL ON RIGHT. ✓
 - 27.0 KEEP LEFT ON DARGALS TRAIL STRUMBO TRAIL ON RIGHT ✓
 - 27.7 TRG JUST ON LEFT SIDE OF ROAD (SMA). ✓

Not to Scale

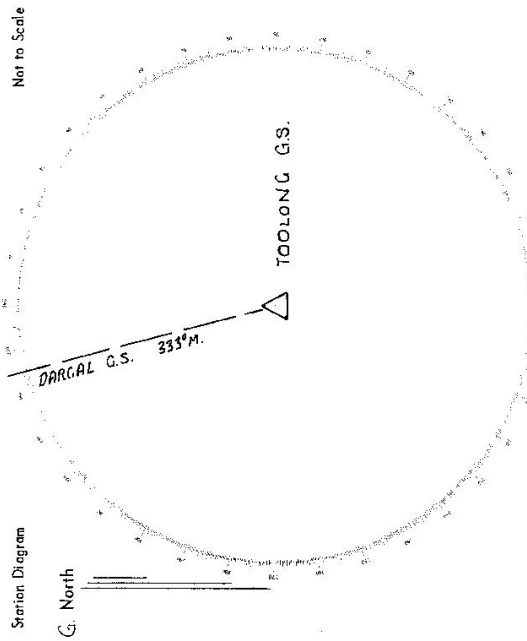

List of Observed Directions:-

Standpoint:		Standpoint:	
Station	Direction	Station	Direction