

CENTRAL MAPPING AUTHORITY

GEODETIC SURVEY OF N.S.W.

GEODETIC STATION RECONNAISSANCE and MAINTENANCE REPORT

Description:
 1. Cleared by lances bearing..... Note: Cross out word or words which do not apply
 2. ~~Mast & Vanes have been painted white & black respectively.~~
 3. The ~~Station~~ ^{Station} ~~marker~~ ^{marker} was ~~unpiled/removed~~ ^{unpiled/removed} on 23-3-82, dimensions now being:

Description of mark..... should be explicit, e.g., S/Steel Pillar Plate, Steel plug, Brass plug, Bolt, G.I. Pipe
 Height of mark.....m. ^{above} rock/concrete; Mark is.....m. ^{above} G.L.
 Height of Top Vanes to Top Mark/Pillar plate.....m. Diameter of Vanes (vertical).....m.
 Height of Cairn.....m. Diameter of Cairn.....m. Name Plate found/not found/placed.
 Length of Mast.....m. (approximate if not unpiled)


4. A..... set in conc/rock has been placed/found, bearing.....° M from Mast/Plug/Pillar
 5. A..... set in conc/rock has been placed/found, bearing.....° M from Mast/Plug/Pillar
 6. A..... set in conc/rock has been placed/found, bearing.....° M from Mast/Plug/Pillar
 7. A..... set in conc/rock has been placed/found, bearing.....° M from Mast/Plug/Pillar
 8. Action required: None required. Station not suitable for use in 1:4000 Mapping Survey

STANDPOINT:

Mark	Direction	Horiz. Distance	Height Difference	Mark	Direction	Horiz. Distance	Height Difference
			above standpt.				above standpt.
			below				below
			above standpt.				above standpt.
			below				below
Prepared by: K. Haddow 1-4-82 Checked: *[Signature]* Noted on U.T.M. Card

St 2733-1

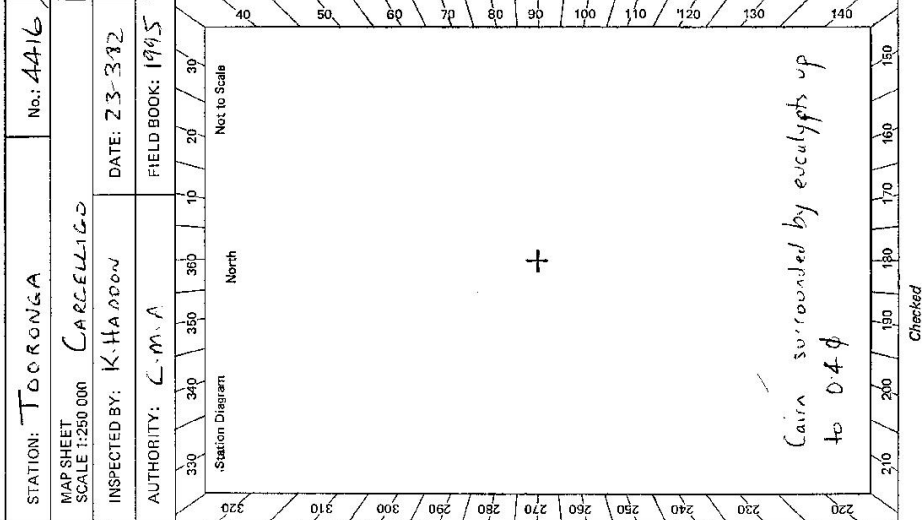

G

STATION TOORONGA TS 4416


Owner's Name: G.S. Elwin
 Address: "Ben Ledi"
 Phone: Lake Cargelligo 1725
 Current Occupant:
 Address:
 Phone:

ACCESS

Access Report of 23/3/1982 was found suitable/unsuitable.

4WD to within 300m up ridge to SE
 10 min walk.

- 0.0 P.O Lake Cargelligo Head west along Foster Street
- 1.0 Straight ahead
- 2.0 Turn left towards Rankin Springs
- 5.6 End of bitumen
- 13.5 Turn right
- 14.8 Dwaris residence "Ben Ledi" on left.
- 15.35 Turn right, go through gate.
- 15.4 Turn left off track. Find your own way along fence and thence up ridge as far as possible.
- 16.1 Stop vehicle Abt 300m walk to trig.

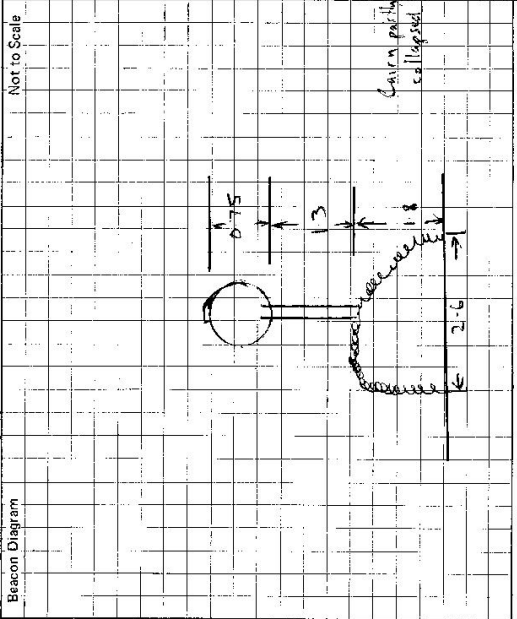

This section to be completed by officer constructing pillar.

Original station mark found/not found.

Description of mark:

Original beacon found/not found.

Description of beacon:

Height Top of Vanes to Top Markm.

Height of markm. above G.L.
 below G.L.

Diameter of Vanesm. Height of Cairnm.

Original Beacon has/has not been destroyed by ma.

Date	Record of Station