

CENTRAL MAPPING AUTHORITY

GEODETIC SURVEY OF N.S.W.

GEODETIC STATION RECONNAISSANCE and MAINTENANCE REPORT

STATION: **TOUT G-S** No.: **4432**

MAP SHEET SCALE 1:250 000

INSPECTED BY: **R. COOK** DATE: **SEPT 1978**

AUTHORITY: **C.M.A.** FIELD BOOK:

Description:
 1. Cleared by lanes bearing.....
 Note: *Cross out word or words which do not apply*

2. Mast & Vanes have been painted white & black respectively.
 3. The station/pillar ~~was repaired~~ (not unpiled/constructed on.....) 19....., dimensions now being:
 Description of mark.....
 Height of mark.....m. ^{above} rock/concrete; Mark is.....m. ^{above} G.L.

Height of Top Vanes to Top Mark/Pillar plate.....m. Diameter of Vanes (vertical).....**25**.....m.
 Height of Cairn.....**1.7**.....m. Diameter of Cairn.....**2.0**.....m. Name Plate found/not found/placed.
 Length of Mast.....**2.85**.....m. (approximate if not unpiled)

4. A..... set in conc/rock has been placed/found, bearing.....°M from Mast/Plug/Pillar

5. A..... set in conc/rock has been placed/found, bearing.....°M from Mast/Plug/Pillar

6. A..... set in conc/rock has been placed/found, bearing.....°M from Mast/Plug/Pillar

7. A..... set in conc/rock has been placed/found, bearing.....°M from Mast/Plug/Pillar

8. Action required: *Extensive clearing needed Good condition Suitable for Pillar.*

STANDPOINT:

STANDPOINT:


Mark	Direction	Horiz. Distance	Height Difference	Mark	Direction	Horiz. Distance	Height Difference
			above standpt.				above standpt.
			below standpt.				below standpt.
			above standpt.				above standpt.
			below standpt.				below standpt.
Prepared by: **R. COOK**

Checked:

Checked

Noted on U.T.M. Card

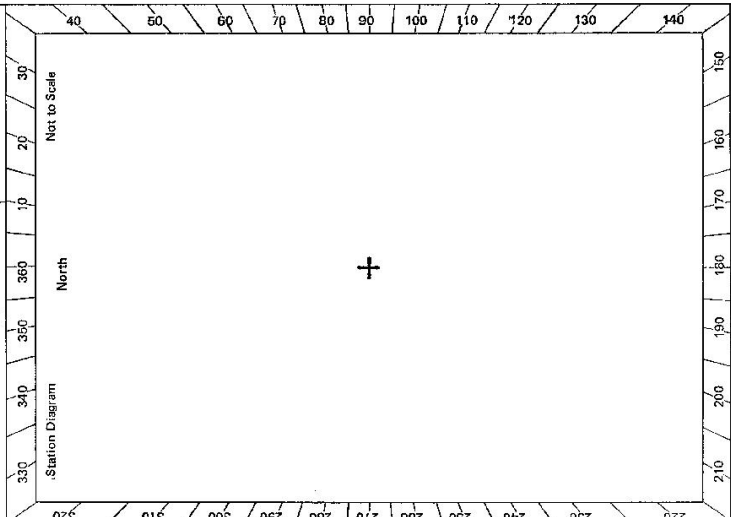

STATION TOUT G.S. JS 4432	Owner's Name: Address: Phone: Current Occupant: Address: Phone: Access Report of Sept 1978 was found suitable/unsuitable. Drive to (access) Found on the Field 1:50,000 Sheet.
Beacon Diagram	Not to Scale
This section to be completed by officer constructing pillar. Original station mark found/not found. Description of mark: Original beacon found/not found. Description of beacon: Height Top of Vanes to Top Mark.....m. Height of mark.....m. above rock/stone.....m. below G.L. Diameter of Vane.....m. Height of Cairn.....m. Original Beacon has/has not been destroyed by me.	
Date SEPT 1978	Record of Station STATION VISITED in connection with Field Completion