

CENTRAL MAPPING AUTHORITY
Department of Lands

Trigonometrical Survey of N.S.W.

RECONNAISSANCE and MAINTENANCE REPORT

This Trig. Station has been:-

Note: Cross out word or words which do not apply

1. Completely cleared to permit 360° vision to surrounding Trig.
2. Cleared by limes-bearing. Needs cleaning along any lines required from Trig. Mast
Need to be could be cleared 360° in 5 days
3. Trig. Mast & Vanes have been painted white & black respectively.
Needs replacing
4. The Trig. was ~~erected~~/not unpled, dimensions now being: _____

Description of mark..... should be explicit, e.g. Steel plug, Brass plug, Bolt, G.I. Pipe

Height of mark..... m above rock/concrete m below G.I.

Height of Top Vanes to Top Mark..... m. Diameter of Vanes (vertical)..... m.

Height of Cairn..... m. Diameter of Cairn..... m.

Length of Mast..... m. (approximate if not unpled)

5. A..... set in conc/rock has been placed..... m. bearing.....°M from Trig. Mast
6. A..... set in conc/soil has been placed..... m. bearing.....°M from Trig. Mast
7. A..... set in conc/soil ~~has been placed~~..... m. bearing.....°M from Trig. Mast
8. A..... set in conc/rock has been placed..... m. bearing.....°M from Trig. Mast

9. Connection..... to..... m. bearing.....°M

10. Connection..... to..... m. bearing.....°M

11. Connection..... to..... m. bearing.....°M

12. Connection..... to..... m. bearing.....°M

13. Diff. Ht. is..... m. above below


14. Diff. Ht. is..... m. above below

15. Diff. Ht. is..... m. above below

16. Diff. Ht. is..... m. above below

Prepared by: _____
Checked: _____
Noted on U.T.M. Card

7-19-96
STATION TOWARRI TS 4434
Co: Brisbane Ph: Willis
Map Sheet: MURURUNDI No: 9034
Inspected by: A. Sivertsen Date: 17.3.77
Authority: CMA Field Book: ~

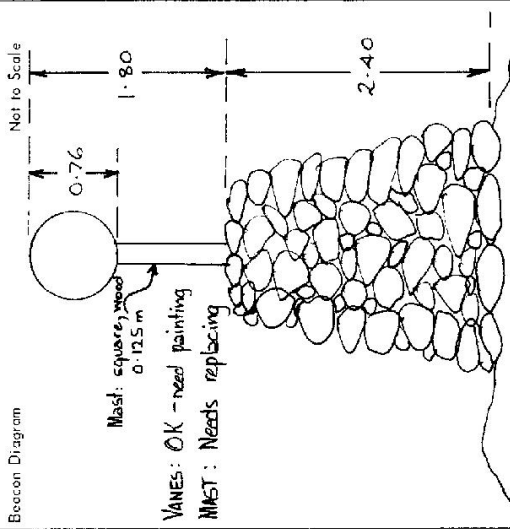

Beacon Diagram
Date _____
Record of Station _____
Checked _____

