

CENTRAL MAPPING AUTHORITY

GEODETIC SURVEY OF R.S.W.

GEODETIC STATION RECONNAISSANCE and MAINTENANCE REPORT

STATION: TREVEETHIN G.I. No.: AA45
 MAP SHEETS SCALE 1:250 000 SCALE 1:100 000
 INSPECTED BY: P. Potts DATE: 11/5/87
 AUTHORITY: C.M.A. FIELD BOOK: 1955


Description:
 1. Cleared by lanes bearing 360° Note: *Cross out word or words which do not apply*
 2. Mast & Vanes have been painted white & black respectively.
 3. The station/~~mark~~ was unpiled/~~erected~~/constructed on 17th May 1987, dimensions now being:
 Description of mark: Not found should be explicit, e.g., S/Steel Pillar Plate, Steel plug, Brass plug, Bolt, G.I. Pipe
 Height of mark: Not found m. above rock/concrete; Mark is Not found m. above G.L.
 Height of Top Vanes to Top Mark/Pillar plate Not found m. Diameter of Vanes (vertical) Not found m.
 Height of Cairn Not found m. Diameter of Cairn Not found m. Name Plate found/not found/placed.
 Length of Mast Not found m. (approximate if not unpiled)

4. A. P.M. set in conc/rock has been placed/~~found~~, bearing Not found °M from Mast/Plug/Pillar
5. A. Not found set in conc/rock has been placed/~~found~~, bearing Not found °M from Mast/Plug/Pillar
6. A. Not found set in conc/rock has been placed/~~found~~, bearing Not found °M from Mast/Plug/Pillar
7. A. Not found set in conc/rock has been placed/~~found~~, bearing Not found °M from Mast/Plug/Pillar
8. Action required: Hill area had been staked - Original Plug not found

STANDPOINT:

Mark	Direction	Horiz. Distance	Height Difference	Mark	Direction	Horiz. Distance	Height Difference
			above standpt.				above standpt.
			below standpt.				below standpt.
			above standpt.				above standpt.
			below standpt.				below standpt.
Prepared by: P. Potts 19/5/87 Checked: AA 19/5/87
 Noted on U.T.M. Grid

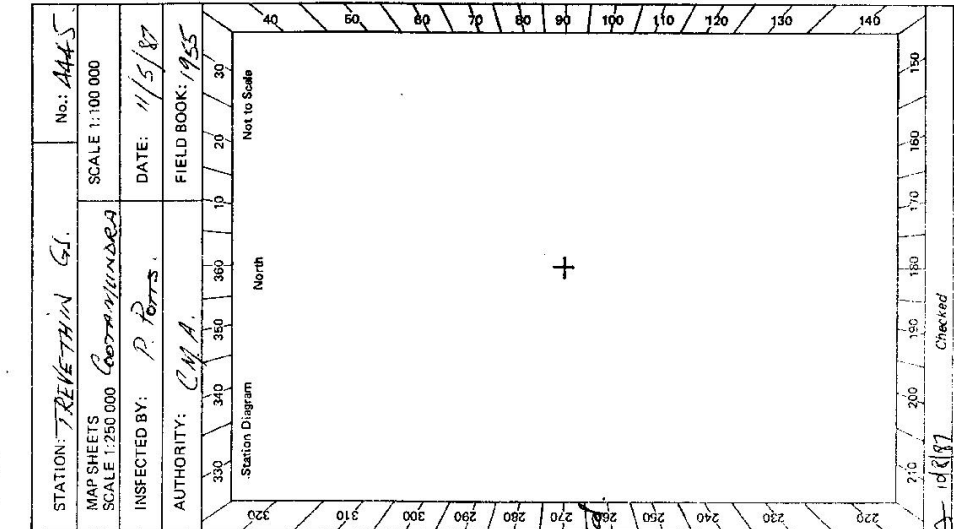

CENTRAL MAPPING AUTHORITY


GEODETIC SURVEY OF N.S.W.

GEODETIC STATION RECONNAISSANCE and MAINTENANCE REPORT

Description: *Note: Cross out word or words which do not apply*
 1. Cleared by lances bearing 360° Bald Hill *from Trig. Mast*
 2. Mast & Vanes have been painted white & black respectively.
 3. The station/pillar was ~~erected~~ re-erected on 18 August 1987, dimensions now being: Description of mark Brass Plug should be explicit, e.g. S/Steel Pillar Plate, Steel plug, Brass plug, Bolt, G.I. Pipe
 Height of mark 0.036 m. above rock/cassette; Mark is 0.10 m. above G.L.
 Height of Top Vanes to Top Mark/Pillar plate 0.000 m. Diameter of Vanes (vertical) 0.77 m.
 Height of Cairn 1.1 m. Diameter of Cairn 1.8 m. Name Plate found/not found/placed.
 Length of Mast ~ m. (approximate if not unplied)
 4. A S/S Pin in conc set in conc/rock has been placed/found, bearing 305.0 M from Mast/Plug/Pillar
 5. A conc set in conc/rock has been placed/found, bearing M from Mast/Plug/Pillar
 6. A conc set in conc/rock has been placed/found, bearing M from Mast/Plug/Pillar
 7. A conc set in conc/rock has been placed/found, bearing M from Mast/Plug/Pillar
 8. Action required: Conc pillar & base in soil to be built

Mark	Brass Plug in Rock		STANDPOINT: S/S Pin in Cover Box	
	Direction 6 DEC	Horiz. Distance	Mark	Direction
MILLBANK (P)	0 00 00	above standpt	MILLBANK (P)	0 00 00
EMERY CMA V	242 09 12.8	below standpt	EMERY CMA V	242 10 00
IRONBONG CMA V	277 09 03.2	below standpt	IRONBONG CMA V	277 09 42.5
ULANDRA TV TOWER	248 28 13.3	above standpt	Brass Plug	304 59 30
S/S Pin in Conc	125 01 17	below standpt		2.548 0.036
		above standpt		above standpt
		below		below
		below		below

Prepared by: A. Siersten Checked: A. Woodroffe . *Noted on U.T.M. Card*

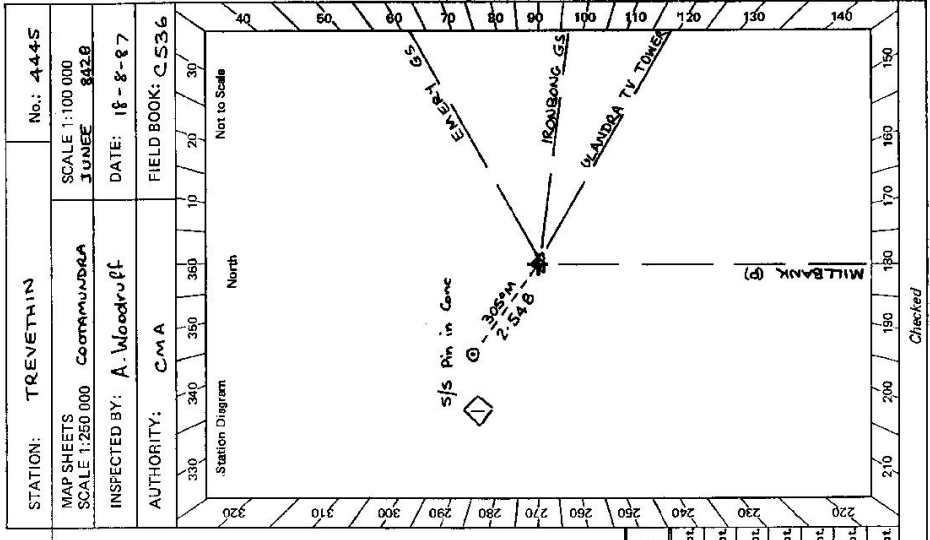

Checked

6. 2735-2 C. West, Government Printer

STATION TREVEETHIN GS TS 4445 Owner's Name: MR BRADDON A. SMITH Address: Phone: Current Occupant: MR CLINT SMITH Address: COOLOOL Phone: 089 247 220	Access Report of 11/5/1982 was found suitable/unavailable. ACCESS: 0.00 AT ROAD JUNCTION AT OLD JUNEE FEATURE 15.40 JUNEE - NAGEA WARRA - TERTORA TAKE TERTORA ROAD 22.29 TURN RIGHT SIGN COMBINING 24 KM TURN RIGHT INTO 'COOLOOL' PROPERTY AT FURPHY'S WATER TANK WHIL BOX 22.41 IRON GATE 22.63 OWNER'S HOUSE ON LEFT 23.26 STRAIGHT AHEAD THIS SIGN DOUBLE IRON GATES PASSING TRACE ON LEFT, FOLLOW TRACE AROUND DIRT AND FOLLOW TRACE ALONG FENCE HEADING EAST 23.40 IRON GATE WHEN HERE LEFT TO TOP OF CLEAR KNODS 24.28 TREVEETHIN TRIG SITE
Beacon Diagram Not to Scale 	This section to be completed by officer constructing pillar. Original station mark found/not found. Description of mark: Original beacon found/not found. Description of beacon: Height Top of Vanes to Top Markm. Height of markm. above G.L. below rock/consm. below Diameter of Vanesm. Height of Cairnm. Original Beacon has/has not been destroyed by me.
	Date Record of Station