

CENTRAL MAPPING AUTHORITY

GEODETIC SURVEY OF N.S.W.

GEODETIC STATION RECONNAISSANCE and MAINTENANCE REPORT

Description:

Note: Cross out word or words which do not apply

1. Cleared by lanes bearing..... 18° to 63° 260° to 370° from Trig. Mast
2. Mast & Vanes have been painted white & black respectively.
3. The station/~~marker~~ was ~~unplaced~~/not unplaced/~~concreted~~ on 26x4x4x4..... 19. ft dimensions now being: Description of mark..... should be explicit, e.g., S/Steel Pillar Plate, Steel plug, Brass plug, Bolt, G.I. Pipe
 Height of mark..... m, above rock/concrete; Mark is..... m, above G.L.
 Height of Top Vanes to Top Mark/Pillar plate m. Diameter of Vanes (vertical)..... 25 m.
 Height of Cairn..... m. Diameter of Cairn..... m. Name Plate ~~found~~/not ~~found~~/placed.
 Length of Mast m. (approximate if not unplied)
4. A..... set in conc/rock has been placed/found, bearing..... ° M from Mast/Plug/Pillar
5. A..... set in conc/rock has been placed/found, bearing..... ° M from Mast/Plug/Pillar
6. A..... set in conc/rock has been placed/found, bearing..... ° M from Mast/Plug/Pillar
7. A..... set in conc/rock has been placed/found, bearing..... ° M from Mast/Plug/Pillar
8. Action required: Place Concrete base & concrete

STANDPOINT:

Mark	Direction	Horiz. Distance	Height Difference	Mark	Direction	Horiz. Distance	Height Difference
			above standpt				above standpt
			below				below
			above standpt				above standpt
			below				below
Prepared by: P.B.T.S.

Checked:

Noted on U.T.M. Card

St 2738-1

STATION: Triang Bi. C3. No.: 4447
 MAP SHEET SCALE 1:250 000
 INSPECTED BY: P.B.T.S. DATE: 28th May 1980
 AUTHORITY: C.M.A. FIELD BOOK: 1108

Station Diagram

Not to Scale

210 220 230 240 250 260 270 280 290 300 310 320

330 340 350 360 370

10 20 30

140 130 120 110 100 90 80 70 60 50 40


150 160 170 180 190 200

Checked: P. Williams 15/9/80

STATION *TRIANGLIE ST.* TS *4447*

Owner's Name:
 Address:
 Phone:
 Current Occupant:
 Address:
 Phone: *26-5-1981*

ACCESS 26-5-1981
 Access Report of *18/01/19* was found suitable/unavailable.
HAND ONLY
FEATREE
0.00 TO EICHARREENA HEADS TOWARDS MCHANGI
0.05 TURN LEFT SIGN "STRAIS TRW" & BURRENDING JAM "
0.60 CROSS RAILWAY LINE
1.80 TURN RIGHT SIGN "SAGHEROS CREEK" & "GUM FLAT"
5.80 TURN LEFT SIGN "GUM FLAT"
6.30 GRID SIGN "GUM FLAT"
9.50 10M GATE SIGN "ROCKY" & 10M GATE
11.00 TURN LEFT SIGN "ROCKY" & 10M GATE
1.80 10M GATE
12.90 10M GATE SIGN "MUMBLE"
14.00 10M GATE
15.00 THREE ABUS TO RIGHT
15.40 10M GATE
16.25 GRID
17.35 10M GATE
18.20 GATEWAY - NO GATE
18.75 10M GATE
20.50 GRID SIGN ON BOT "ROCKY"
21.80 PASS TRUCK ON LEFT
22.50 GRID STRAIGHT AHEAD ON HUNT TRUCK
22.70 10M GATE
23.05 10M GATE
23.30 PASS TRUCK ON LEFT
24.20 10M GATE
25.40 TURN LEFT SIGN "STRAIS TRW" & BURRENDING JAM "
25.45 CROCKETIC STATION TRIANGLIE

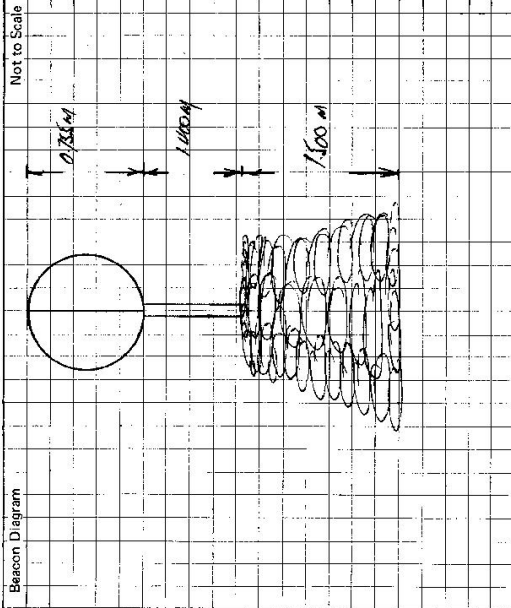

This section to be completed by officer constructing pillar.

Original station mark found/not found.

Description of mark:

Original beacon found/not found.

Description of beacon:

Height Top of Vanes to Top Markm.

Height of mark:m. above G.L.
m. below

Diameter of Vanesm.

Original Beacon has/has not been destroyed by mo. Height of Cairnm.

St 2733-2 D. West, Government Printer

STATION	TRIANGLE	TS 4447
<p>Access Owner's Name: GARRY M. O'BRIEN</p> <p>Address: "ROCKY"</p> <p>Phone: (063) 658311</p> <p>Access Report of 15/7/1981 was found unsuitable (unsuitable).</p> <p>Feature</p> <p>P.O. EUGHAREENA ~ HEAD EAST TOWARDS RAILWAY</p> <p>TURN LEFT</p> <p>RAILWAY CROSSING ~ FOLLOW RD TO LEFT</p> <p>PASS RD. ON RIGHT TO 'SHEPHERD'S CK.</p> <p>CAUSEWAY</p> <p>TURN RIGHT ~ SIGN 'MT TOP 2 BUNDALA 10'</p> <p>TURN RIGHT AND OVER GRID.</p> <p>TAKE LEFT FORK</p> <p>TURN RIGHT ~ 'MOUNT TOP' ON LEFT</p> <p>GRID</p> <p>CAUSEWAY</p> <p>IRON GATE</p> <p>GRID ~ SIGN 'WOMBLE'</p> <p>GRID</p> <p>TURN RIGHT ~ HOMESTEAD ON LEFT</p> <p>GRID</p> <p>CROSS GREEK & TURN LEFT</p>	<p>OWNER OF PROPERTY TO THE SOUTH OF THE GARRETT BROS. TRIG</p> <p>Address: 7 CUMMINGS ST.</p> <p>ORANGE</p> <p>Phone: VACANT CROWN LAND OF 3 ACRES APPROX</p> <p>NOTE: IS SITUATED AROUND THE TRIG BUT HAS NOT BEEN FORMALLY PROCLAIMED AS A TRIG RESERVE.</p> <p>Feature</p> <p>IRON GATE</p> <p>GRID</p> <p>CROSS CREEK</p> <p>IRON GATE</p> <p>CROSS CREEK</p> <p>GRID</p> <p>CROSS CREEK</p> <p>GRID & GATE ~ 'ROCKY' HOMESTEAD ON RIGHT ~ DRIVE STRAIGHT AHEAD</p> <p>IRON GATE</p> <p>TAKE RIGHT FORK</p> <p>IRON GATE</p> <p>'TRIANGLE' TRIG.</p>	<p>Access Report of 15/7/1981 was found unsuitable (unsuitable).</p> <p>Feature</p> <p>P.O. EUGHAREENA ~ HEAD EAST TOWARDS RAILWAY</p> <p>TURN LEFT</p> <p>RAILWAY CROSSING ~ FOLLOW RD TO LEFT</p> <p>PASS RD. ON RIGHT TO 'SHEPHERD'S CK.</p> <p>CAUSEWAY</p> <p>TURN RIGHT ~ SIGN 'MT TOP 2 BUNDALA 10'</p> <p>TURN RIGHT AND OVER GRID.</p> <p>TAKE LEFT FORK</p> <p>TURN RIGHT ~ 'MOUNT TOP' ON LEFT</p> <p>GRID</p> <p>CAUSEWAY</p> <p>IRON GATE</p> <p>GRID ~ SIGN 'WOMBLE'</p> <p>GRID</p> <p>TURN RIGHT ~ HOMESTEAD ON LEFT</p> <p>GRID</p> <p>CROSS GREEK & TURN LEFT</p>
<p>Beacon Diagram</p> <p>Not to Scale</p> <p><i>MAST, VANES & CAIRN IN GOOD CONDITION CAIRN HAS PARTLY COLLAPSED</i></p>	<p>This section to be completed by officer constructing pillar.</p> <p>Original station mark found/not found.</p> <p>Description of mark:</p> <p>Original beacon found/not found.</p> <p>Description of beacon:</p> <p>Height Top of Vanes to Top Markm.</p> <p>Height of mark:m. above G.L. below</p> <p>Diameter of Vanesm. Height of Cairnm.</p> <p>Original Beacon has/has not been destroyed by me.</p>	
<p>Date</p>	<p>Record of Station</p>	