

GEODETIC SURVEY OF M.S.W.

CENTRAL MAPPING AUTHORITY


GEODETIC STATION RECONNAISSANCE and MAINTENANCE REPORT

STATION: TUCKLIL BRI No.: 4458

MAP SHEET SCALE 1:250 000 NAEROMINE

INSPECTED BY: G. C. HANNA DATE: 3/10/78


AUTHORITY: C.M. 4. FIELD BOOK:

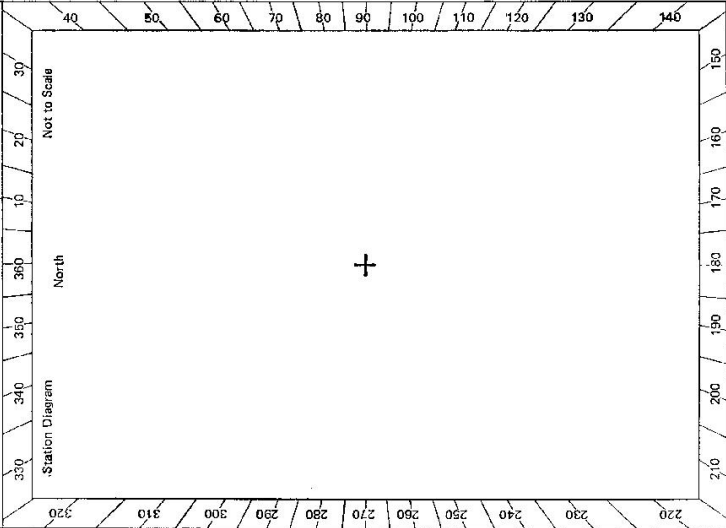

- Description:
- Cleared by lanes bearing.....  
*Note: Cross out word or words which do not apply*
  - Mast & Vanes have been painted white & black respectively.
  - The station/pillar was unspliced/not unspliced/constructed on.....19....., dimensions now being:  
Description of mark.....should be explicit, e.g., S/Steel Pillar Plate, Steel plug, Brass plug, Bolt, G.I. Pipe  
Height of mark.....m.....<sup>above</sup> rock/concrete; Mark is.....m.....<sup>above</sup> G.L.  
Height of Top Vanes to Top Mark/Pillar plate.....m. Diameter of Vanes (vertical).....m.  
Height of Cairn.....m. Diameter of Cairn.....m. Name Plate found/not found/placed.  
Length of Mast.....m. (approximate if not unspliced)
  - A.....set in conc./rock has been placed/found, bearing.....°M from Mast/Plug/Pillar
  - A.....set in conc./rock has been placed/found, bearing.....°M from Mast/Plug/Pillar
  - A.....set in conc./rock has been placed/found, bearing.....°M from Mast/Plug/Pillar
  - A.....set in conc./rock has been placed/found, bearing.....°M from Mast/Plug/Pillar
  - Action required:.....

STANDPOINT:			
Mark	Direction	Horiz. Distance	Height Difference
			above standpt.
			below standpt.
			above standpt.
			below standpt.
Prepared by: G. Hanna Checked: Noted on U.T.M. Card

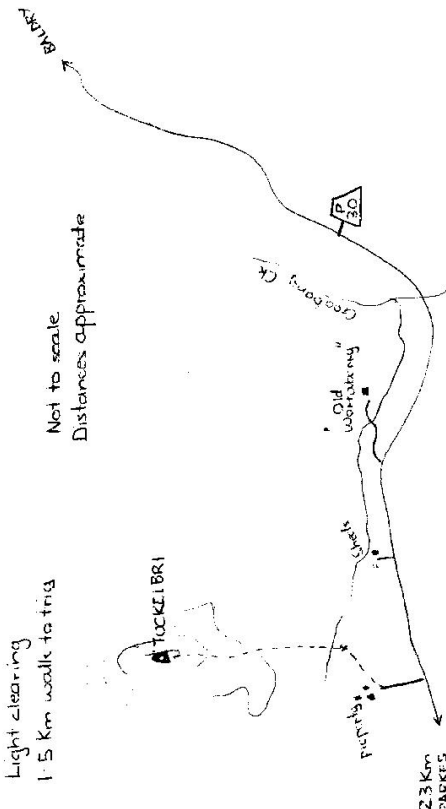ST 2733-2 D. West, Government Printer	STATION <b>TUCKELBRI</b> IS <b>4458</b>	Owner's Name: ..... Address: ..... Phone: ..... Current Occupant: ..... Address: ..... Phone: .....	ACCESS Access Report of <u>3/10/1978</u> was found suitable/unsuitable. Carn 1m. Mast 8 vares 2m. Light clearing 1-5 Km walk to trig Not to scale Distances approximate 
Beacon Diagram Not to Scale	This section to be completed by officer constructing pillar. Original station mark found/not found. Description of mark: ..... Original beacon found/not found. Description of beacon: ..... Height Top of Vanes to Top Mark ..... m. Height of mark ..... m. above G.L. below Diameter of Vanes ..... m. Height of Cairn ..... m. Original Beacon has/has not been destroyed by me.		
Date		Record of Station	