

GEODETTIC SURVEY OF N.S.W.

CENTRAL MAPPING AUTHORITY

GEODETTIC STATION RECONNAISSANCE and MAINTENANCE REPORT

Description:

Note: Cross out word or words which do not apply

1. Cleared by lanes bearing.....
2. Mast & Vanes have been painted white & black respectively. ^{orange}..... from Trig. Mast
3. The station/pillar was ~~erected~~ ^{erected} on..... / 3.7 / 19.7.7.7, dimensions now being:
 - Description of mark..... should be explicit, e.g., S/Steel Pillar Plate, Steel plug, Brass plug, Bolt, G.I. Pipe
 - Height of mark..... m. ^{above} rock/concrete; Mark is..... m. ^{above} G.L., ^{below}
 - Height of Top Vanes to Top Mark/Pillar plate..... m. Diameter of Vanes (vertical)..... / 0/..... m.
 - Height of Cairn..... / 1.6..... m. Diameter of Cairn..... / 2..... m. Name Plate found/not found/placed.
 - Length of Mast..... 3.7..... m. (approximate if not unipiled)
4. A..... set in conc/rock has been placed/found, bearing..... °M from Mast/Plug/Pillar
5. A..... set in conc/rock has been placed/found, bearing..... °M from Mast/Plug/Pillar
6. A..... set in conc/rock has been placed/found, bearing..... °M from Mast/Plug/Pillar
7. A..... set in conc/rock has been placed/found, bearing..... °M from Mast/Plug/Pillar
8. Action required:..... STATION IS SUITABLE FOR COALS PILLAR. ^{PRESENT} IS A POOR CONDITION.....

STANDPOINT:

Mark	Direction	Horiz. Distance	Height Difference	Mark	Direction	Horiz. Distance	Height Difference
			above standpt				above standpt
			below				below
			above standpt				above standpt
			below				below
Prepared by:

8.8.78

Checked:

St 2/783-1

STATION: TUOHY No.: TS 4473

MAP SHEET NARRANDERA

SCALE 1:250 000

INSPECTED BY: P. Naylor DATE: 13.7.77


AUTHORITY: C.M.A. FIELD BOOK:

North

Not to Scale

Checked

Sc 2739-2 D. West, Government Printer

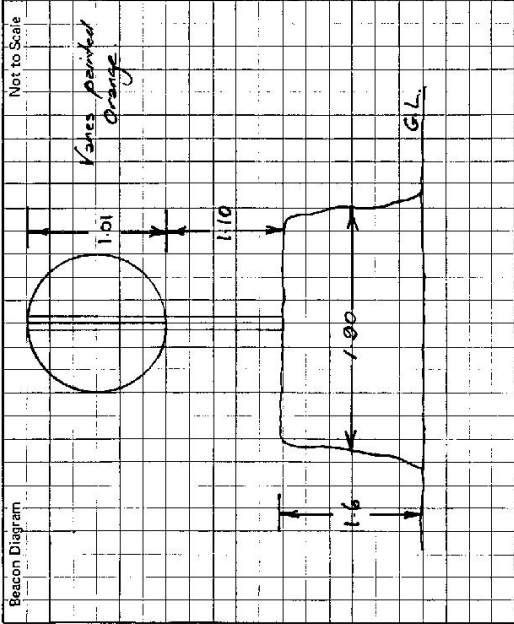

This section to be completed by officer constructing pillar.

Original station mark found/not found.

Description of mark:

Original beacon found/not found.

Description of beacon:

Height Top of Vanes to Top Mark.....m.

Height of mark.....m. above G.L. below rock/cconc.....m.

Diameter of Vanesm. Height of Cairnm.

Original Beacon has/has not been destroyed by me.

STATION	TUOHY TS 4473		
Owner's Name: W.R.C Address: LEFION Phone: Remains T.R of 49 acres.	Current Occupant: Lance Cook (Lessee) Address: Marrwong Phone:	ACCESS Access Report of B. J. 1977 was found suitable/unsuitable. NABANDERA 1:250,000 MAP REFERENCE A25/749	
Date:	Record of Station:	Sited <input checked="" type="checkbox"/> Marrwong Road <input type="checkbox"/> SUB MARRAMI 0.06 0.06	