

CENTRAL MAPPING AUTHORITY
Department of Lands

Trigonometrical Survey of N.S.W.
RECONNAISSANCE and MAINTENANCE REPORT

7406

STATION **TURIMETTA G.S. (PILLAR) TS 4478**

Co: **CUMBERLAND** Ph: **NARRABEEN**

Map Sheet: **SYDNEY** No: **9130**

Inspected by: **W. M. GILLURAY** Date: **5/8/75**

Authority: **CENTRAL MAPPING** Field Book:


This Trig. Station has been:- Note: Cross out word or words which do not apply

1. Completely cleared to permit 360° vision to surrounding Trigs.
2. Cleared by lones bearing..... from Trig. Mast
3. Trig. Mast & Vanes have been painted white & black respectively.
4. The Trig. was unpiled/not unpiled, dimensions now being:
Description of mark... **S/S. PILLAR PLATE** should be explicit, e.g. Steel plug, Brass plug, Bolt, G. I. Pipe
Height of mark... **1.465** m above **rock/concrete** m above **G.L.**
Height of Top Vanes to Top Mark... **1.475** m. Diameter of Vanes (vertical) **0.750** m.

5. A..... m. Diameter of Cairn..... m.
Length of Mast... **1.555** m. (approximate if not unpiled)
6. A..... set in conc/rock has been placed..... m. bearing.....°M from Trig. Mast
7. A..... set in conc/soil has been placed..... m. bearing.....°M from Trig. Mast
8. A..... set in conc/soil has been placed..... m. bearing.....°M from Trig. Mast

9. Connection..... to..... m. bearing.....°M
10. Connection..... to..... m. bearing.....°M
11. Connection..... to..... m. bearing.....°M
12. Connection..... to..... m. bearing.....°M
13. Diff. Ht. is..... m. above
below
14. Diff. Ht. is..... m. above
below
15. Diff. Ht. is..... m. above
below
16. Diff. Ht. is..... m. above
below

Prepared By: **Bob Lunde 11/1/76** Checked: **Robby 11/1/76** Noted on U.T.M. Card

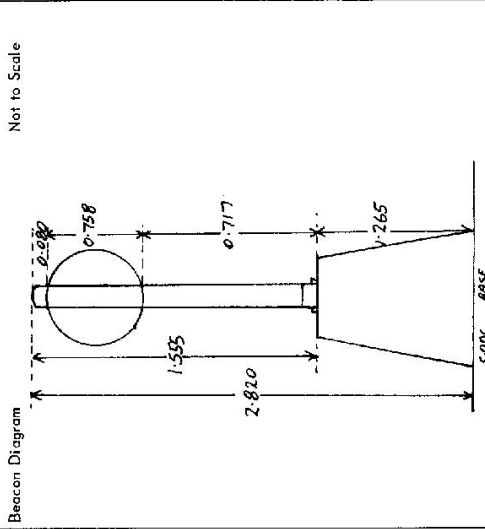

Date	Record of Station
5-8-75	NEW MAST & VANES ERECTED

Checked

75 193

Department of Lands STATION TURIMETTA TS 4478
 RECONNAISSANCE and MAINTENANCE REPORT

This Trig. Station has been:-

- 1. Completely cleared to permit 360° vision to surrounding Trigs.
- 2. ~~Cleared~~ by lanes bearing..... from Trig. Mast
- 3. Trig. Mast & Vanes have been painted white & black respectively.
- 4. The Trig. was unpiled/~~not completed~~, dimensions now being:

Description of mark..... ~~CONCRETE~~ ^{PILLAR} should be explicit, e.g. Steel plug, Brass plug, Bolt, Concrete Pillar

Height of mark..... 1.25 m ^{above} ~~concrete~~ ^{G.L.} m above/below

Height of Top Vanes to Top Mark/Top pillar plate... 1.46 m Diameter of Vanes (vertical) 0.60 m.

Height of Cairn..... m. Diameter of Cairn..... m.

Length of Mast..... m. (approximate if not unpiled)

5. A. TRIG. PILLAR set in conc./~~rock~~ has been placed/fd 2.624 m. bearing 335°M from Trig. Mast/pillar

6. A. ~~CONCRETE~~ ^{IRON} set in conc./soil has been placed/fd 1.729 m. bearing 35°M from Trig. Mast/pillar

7. A..... set in conc./soil has been placed/fd..... m. bearing.....°M from Trig. Mast/pillar

8. A..... set in conc./rock has been placed/fd..... m. bearing.....°M from Trig. Mast/pillar

9. Connection: TRIG. PILLAR CONCRETE 2.286 m. bearing 115°M

10. Connection..... to..... m. bearing.....°M

11. Connection..... to..... m. bearing.....°M

12. Connection..... to..... m. bearing.....°M

13. Diff. Ht. TRIG. PILLAR is 1.568 m. ^{below} PILLAR PLATE

14. Diff. Ht. CONCRETE is 1.380 m. ^{below} PILLAR PLATE


15. Diff. Ht. is..... m. ^{above}

16. Diff. Ht. is..... m. ^{below}

Prepared by: W. Staley Checked: W. Staley 26/12/77

Co: CUMBERLAND | Ph: NARRABEEN
 Map Sheet: MONA VALE | No: 2767
 Inspected by: C. N. STARKY | Date: 23/3/77
 Authority: DEPT LANDS | Field Book: 873.

Beacon Diagram Not to Scale

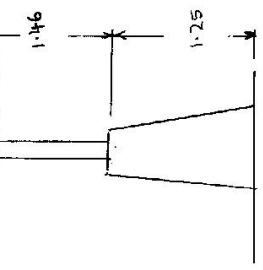

Date	Record of Station
11/2/80	SIGNAL REPLACED BY WARRINGOH SHIRE COUNCIL

GEODETIC SURVEY OF N.S.W.

CENTRAL MAPPING AUTHORITY

GEODETIC STATION RECONNAISSANCE and MAINTENANCE REPORT

Description:

1. Cleared by lanes bearing.....
 Note: Cross out word or words which do not apply
 from Trig. Mast

2. Mast & Vanes have been painted white & black respectively.

3. The station/pillar was unpiled/not unpiled/constructed on..... 19....., dimensions now being:

Description of mark.....should be explicit, e.g., S/Steel Pillar Plate, Steel plug, Brass plug, Bolt, G.I. Pipe

Height of mark.....m. above below rock/concrete; Mark is.....m. above below G.L.

Height of Top Vanes to ~~Top Mast~~/Pillar plate/.....m. Diameter of Vanes (vertical)...../.....m.

Height of Cairn.....m. Diameter of Cairn.....m. Name Plate found/not found/placed.

Length of Mast.....m. (approximate if not unpiled)

4. A.....set in conc/rock has been placed/found, bearing.....°M from Mast/Plug/Pillar

5. A.....set in conc/rock has been placed/found, bearing.....°M from Mast/Plug/Pillar

6. A.....set in conc/rock has been placed/found, bearing.....°M from Mast/Plug/Pillar

7. A.....set in conc/rock has been placed/found, bearing.....°M from Mast/Plug/Pillar

8. Action required:.....

STANDPOINT:

STANDPOINT:


Mark	Direction	Horiz. Distance	Height Difference	Mark	Direction	Horiz. Distance	Height Difference
			above standpt				above standpt
			below				below
			above standpt				above standpt
			below				below
Prepared by: J. J. J. J.

Noted on U.T.M. Card

Checked

STATION: TURINNETTA (P) No.: L-4-7A
 MAP SHEETS SCALE 1:250 000 SYDNEY S1/56-S SCALE 1:100 000 SYDNEY 9/30
 INSPECTED BY: SURVEY CONTROL DATE: 26. 10. 83
 AUTHORITY: CROWN LANDS OFFICE FIELD BOOK:

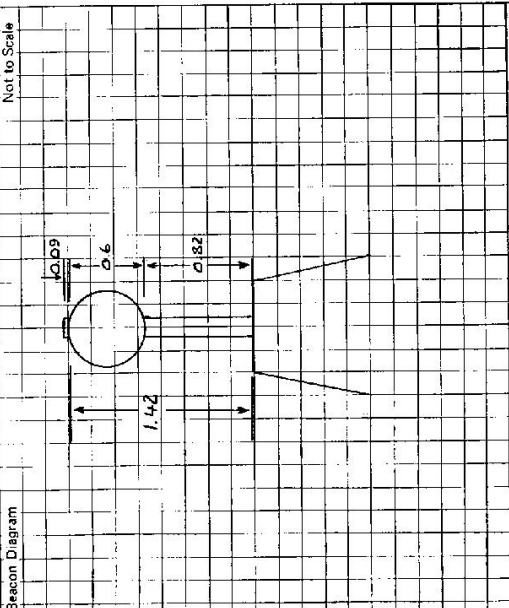STATION TURINETTA (P)	Owner's Name: Address: Phone: Current Occupant: Address: Phone: ACCESS Access Report of/...../19.....was found suitable/unsuitable.
Beacon Diagram Not to Scale 	This section to be completed by officer constructing pillar. Original station mark found/not found. Description of mark: Original beacon found/not found. Description of beacon: Height Top of Vanes to Top Markm. Height of markm. above G.L. below rock/concm. below Diameter of Vanesm. Height of Cairnm. Original Beacon has/has not been destroyed by me.
Date 26.10.53	Record of Station Mast and vanes placed by Surveyor General, British Colonial, South Africa

75-193

Department of Lands
Integral Survey of N.S.W.
RECONNAISSANCE and MAINTENANCE REPORT

This Trig. Station has been:-

Noted: Cross out word or words which do not apply

1. ~~Completely cleared to permit 360° vision to surrounding Trig.~~
2. ~~Cleaned by lens-bearing~~ REPAIRED CAPSTONE from Trig-Mast
3. Trig. Mast & Vanes have been painted white & black respectively.
4. ~~The Trig. was unpiled/not-unpiled, dimensions not being:~~

Description of mark should be explicit, e.g. Steel plug, Brass plug, Ball, Concrete Pillar

Height of mark m ^{above} rock, concrete m ^{below} G.L.

Height of Top Vanes to Top Mark/Top pillar plate m Diameter of Vanes (vertical) m.

Height of Cairn m. Diameter of Cairn m.

Length of Mast m. (approximate if not unpiled)

5. A. set in conc./rock has been placed/d m. bearing°M from Trig. Mast/pillar
6. A. set in conc./soil has been placed/d m. bearing°M from Trig. Mast/pillar
7. A. set in conc./soil has been placed/d m. bearing°M from Trig. Mast/pillar
8. A. set in conc./rock has been placed/d m. bearing°M from Trig. Mast/pillar

9. Connection to m. bearing°M
10. Connection to m. bearing°M
11. Connection to m. bearing°M
12. Connection to m. bearing°M

13. Diff. Ht. is m. ^{above} below
14. Diff. Ht. is m. ^{above} below
15. Diff. Ht. is m. ^{above} below
16. Diff. Ht. is m. ^{above} below

Prepared by: _____

Checked: _____

STATION **TURIMETTA (P) TS 4478**

Co: _____ Ph: _____

Map Sheet: **MONA VALE** No: _____

Inspected by: **P. MADDEN** Date: **30.5.87**

Authority: **Survey Control Branch** Field Book: _____

Beacon Diagram Not to Scale

Date: _____ Record of Station

30.5.87 Mast & Vanes replaced - previous mast and vanes destroyed by vandals

STATION / TURIMETTA TS, 4478

Owners Name:
 Current Occupant:
 Address:
 Address:

Access 23/3/1977 ON TURIMETTA HEAD NORTH NARRABEEN
 UED MAP 18 D5.
 From Narrabeen Park Rd, Narrabeen, turn east onto track just south of Turimetta Head, 2 WD to TS.

