

GEODETTIC STATION RECONNAISSANCE and MAINTENANCE REPORT

Description:

1. Cleared by lanes bearing..... *Note: Cross out word or words which do not apply*..... from Trig. Mast
2. Mast & Vanes have been painted white & black respectively.
3. The station/pillar was unpiled/not unpiled/constructed on..... 19..... dimensions now being:
Description of mark..... should be explicit, e.g., S/Steel Pillar Plate-Steel plug, Brass plug, Bolt, G.I. Pipe
Height of mark.....m. ^{above} rock/concrete; Mark is.....m. ^{above} G.L.
Height of Top Vanes to Top Mark/Pillar plate.....m. Diameter of Vanes (vertical).....m.
Height of Cairn.....m. Diameter of Cairn.....m. Name Plate found/not found/placed.
Length of Mast.....m. (approximate if not unpiled)
4. A..... set in conc/rock has been placed/found, bearing.....° M from Mast/Plug/Pillar
5. A..... set in conc/rock has been placed/found, bearing.....° M from Mast/Plug/Pillar
6. A..... set in conc/rock has been placed/found, bearing.....° M from Mast/Plug/Pillar
7. A..... set in conc/rock has been placed/found, bearing.....° M from Mast/Plug/Pillar
8. Action required:.....

STANDPOINT:

Mark	Direction	Horiz. Distance	Height Difference	Mark	Direction	Horiz. Distance	Height Difference
			above standpt.				above standpt.
			below				below
			above standpt.				above standpt.
			below				below
Prepared by:

Checked:

Noted on U.T.M. Card

S12733-1

STATION: ULALU	No.: 4497
MAP SHEET SCALE 1:250 000	
INSPECTED BY: G.C. HANNA	DATE: 24/5/79
AUTHORITY: C.M.A.	FIELD BOOK:

St 2735—2 D. War, Government Printer		STATION	ULALU	TS 4497
<p>Beacon Diagram</p> <div style="border: 1px solid black; width: 100%; height: 150px; position: relative;"> <div style="position: absolute; top: 0; right: 0; font-size: 8px;">Not to Scale</div> </div>	<p>Owner's Name:</p> <p>Address:</p> <p>Phone:</p> <p>Current Occupant:</p> <p>Address:</p> <p>Phone:</p> <p>ACCESS See Euabalong 8131-N</p> <p>Access Report of 24.5.1978 was found suitable/unsuitable.</p> <p>Cairn, mast & vanes found in good condition.</p> <p>15 minute walk.</p> <p>Light to medium clearing.</p> <p>Previously visited in 1973.</p>			
<p>This section to be completed by officer constructing pillar.</p> <p>Original station mark found/not found.</p> <p>Description of mark:</p> <p>Original beacon found/not found.</p> <p>Description of beacon:</p> <p>Height Top of Vanes to Top Markm.</p> <p>Height of markm. above below rock/concm. above below G.L.</p> <p>Diameter of Vanesm. Height of Cairnm.</p> <p>Original Beacon has/has not been destroyed by me.</p>		<p>Date</p> <p>Record of Station</p>		

LAND INFORMATION CENTRE

GEODETIC SURVEY OF A.S.W.

GEODETIC STATION RECONNAISSANCE and MAINTENANCE REPORT

Description:

1. Cleared by lanes bearing.....
 Note: Cross out word or words which do not apply
2. Mast & Vanes have been painted white & black respectively.
 from Trig. Mast
3. The station/pillar was unplied/~~not unplied~~/~~constructed~~ on..... 25 OCT 1994, dimensions now being:
 Description of mark.....
 Height of mark.....m. above ~~rock~~ below concrete; Mark is 0.2.....m. above ~~below~~ G.L.
 Height of Top Vanes to Top Mark/Pillar plate ~~Vaness sit on top of~~ ~~Vaness sit on top of~~ Diameter of Vanes (vertical) 0.90.....m.
 Height of Cairn.....1.5.....m. Diameter of Cairn.....2.0.....m. Name Plate found/not found/placed.
- Length of Mast.....m. (approximate if not unplied)
4. A. ~~Cu Tube~~ set in conc/~~rock~~ has been placed/found, bearing.....° M from Mast/Plug/Pillar
5. A. " set in conc/~~rock~~ has been placed/found, bearing.....° M from Mast/Plug/Pillar
6. A. " set in conc/~~rock~~ has been placed/found, bearing.....° M from Mast/Plug/Pillar
7. A. " set in conc/~~rock~~ has been placed/found, bearing.....° M from Mast/Plug/Pillar
8. Action required: ~~REPLING + NEW MAST~~ VANES OK ~~RECONSTRUCTION FROM A.S.W.~~

STANDPOINT: Cu Tube in Conc (RM1) BEAR: 25.10.94 TRIG PLUG Tapcon FC4 2 sets


Mark	Direction	Horiz. Distance	Height Difference	Mark	Direction	Horiz. Distance	Height Difference
WARRAWAY G.S. (Mast)	0 00 00		above standpt	WARRAWAY C.M.V	0 00 00		above standpt
Tube in conc (RM2)	135 53 45	8.458	0.086 above standpt	RM 1	345 46 30	5.517	0.138 above standpt
IG PLUG	165 45 55	5.510	0.138 above standpt	RM 2	99 06 50	4.587	0.194 above standpt
Tube in Conc (RM3)	193 15 30	8.152	0.030 above standpt	RM 3	231 17 25	4.134	0.107 above standpt
			below standpt				below standpt
			above standpt				above standpt
			below standpt				below standpt
			above standpt				above standpt
			below standpt				below standpt

Prepared by: M MORRISON 11/10/94 Checked: M. P. 20.10.94 Noted on U.T.M. Card

AS 18.11.94

Checked

Batch 1667

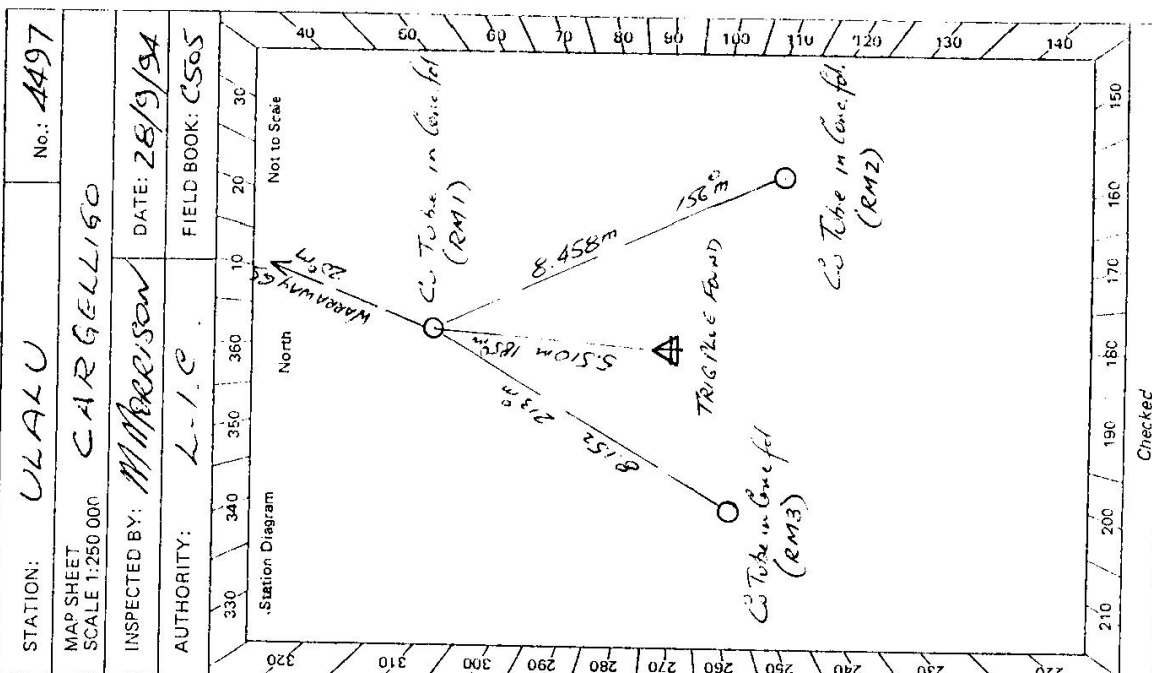

SI 2733-2 D. West, Government Printer

Beacon Diagram		Not To Scale	
<p>Owner's Name:</p> <p>Address:</p> <p>Phone:</p> <p>Current Occupant:</p> <p>Address:</p> <p>Phone:</p> <p>Access Report of/19..... was found suitable/unsuitable.</p> <p><u>28/9/94</u></p> <p><u>ACCESS</u></p> <p>AT ROYAL HOTEL MOUNT HOPE HEAD SOUTH TOWARDS HILLSTON FOR 175m</p> <p>TO MATAKANA RAILWAY CROSSING</p> <p>Km</p> <p>0.00 AT MATAKANA RAILWAY CROSSING HEAD SOUTH TOWARDS HILLSTON</p> <p>18.0 TURN LEFT ONTO TRACK AT SIGN "MUMMINNIE NATURE RESERVE"</p> <p>21.1 HEADING EAST.</p> <p>26.7 IRON GATE. STRAIGHT AHEAD PAST OLD WINDMILL + BRK</p> <p>29.9 " " " "</p> <p>30.6 PASS TRACK ON LEFT.</p> <p>31.2 WIRE GATE. STRAIGHT AHEAD</p> <p>34.3 TURN LEFT ONTO MAIN TRACK ON WEST OF RANGE</p> <p>TURN RIGHT OFF GRADED TRACK ONTO FAINT TRACK (JUST BEFORE PINES) KEEPING GROVE OF PINES ON LEFT + HILL ON RIGHT FOLLOW FAINT TRACK KEEPING CREEK ON LEFT.</p> <p>AT END OF GULLY AHEAD UP HILL, MAKE DOWNWAY SOUTH UP HILL + ALONG RIDGE TO TRIG</p> <p>ULALU TRIG.</p>		STATION	
		ULALU	
		1497	
		Date	
		Record of Station	
		Height: Top of Vane to Top Mark	
		Height of mark	
		Diameter of Vane	
		Original Beacon has/has not been destroyed by me.	